

JACKSON COUNTY APPROVED LAND CORNER P.A. 345 of 1990

LIBER 1465 PAGE 1299

Chairman [Signature] SOUTHWEST CORNER SECTION 35 TOMPKINS TOWNSHIP LAND CORNER RECORDATION CERTIFICATE

Date Dec. 20, 1994

Filing Requirement of Act 74, Mich. P.A. 1970

For corners in

Form with fields for JACKSON (County), Located In, Corner Code, and numbered items 1-5 for Public Land Survey, Property Controlling, etc.

STATE OF MICHIGAN JACKSON COUNTY RECORDED

2 MAY 95 8:23 A.M.

GERALD J. McDEVITT REGISTER OF DEEDS

Register of Deeds Stamp & File Number

Grid table with columns A-L and rows 1-13, containing numbers 1-36.

I, RONALD L. ENGER, in a field survey on NOVEMBER 7, 19 94, do hereby certify that under requirements of P.A. 74, Michigan P.A. of 1970, the corner points mentioned in lines 1 and 2 above were in conformance with regulations and rules therefore as required in the current manual of survey instructions of the United States Department of the Interior, Bureau of Land Management or by a decree of a Court of Law and/or that the corner points mentioned in lines 3, 4 and 5 above were in conformance with the rules of the Michigan Board of Land Surveyors or by a Decree of a Court of Law; established, re-established, monumented, re-monumented, recovered, found as expressed below:

NOTE: Not more than 4 corners, all in the same town and range, may be recorded on this certificate.

A. Description of original monument and accessories and/or subsequent restoration:

1. GLO JOSEPH WAMPLER, DS, ESTABLISHED CORNER IN ORIGINAL GOVERNMENT SURVEY IN JANUARY 1824; WO 18 N85-1/2W 240 (158.4') AND DO. 20 N64E 445 (271.7')

2. ON OCTOBER 31, 1885, JOHN HOLCROFT REPORTED "FOUND OLD POST AND BOTH WITNESS STUMPS" AND RECORDED 2 WITNESSES: Y. OAK 16 S82W 210 (138.6') AND DO 8 S19W 276 (182.2')

\$ 2.00 REMONUMENTATION \$ 9.00 CORNER REMONUMENTATION

CONTINUED ON BACK


B. Description of corner evidence found and/or method applied in restoring or reestablishing corner:

SEARCHED AT APPARENT LOCATION OF CORNER AND FOUND FIRECLAY POST WITH 1/2 INCH PIPE ALONGSIDE 4 FEET EAST OF FENCE CORNER (FENCES TO NORTH, EAST AND WEST). ACCEPTED THE FIRECLAY AS CORNER POSITION AS PERPETUATED BY HOLCROFT. REMOVED FIRECLAY POST AND SET STANDARD MONUMENT FOR PA 345 REMONUMENTATION IN JACKSON COUNTY IN ITS PLACE.

SURVEY & REMONUMENTATION

MAY 17 1995

COMMISSION

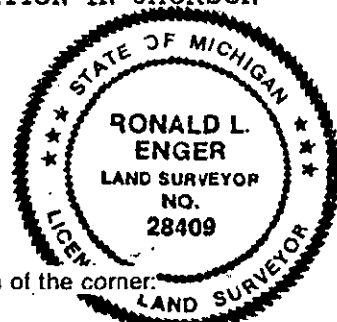

C. Description of monument for corner and accessories established to perpetuate locating the position of the corner:

Table with 3 columns: Bearing/Angle, Distance, and Monument Description (e.g., 53° NAZ 40" OAK 559.10' NAIL & TAG LS 28409 IN NORTH SIDE).

NOTE: NAZ IS MAGNETIC AZIMUTH MEASURED FROM NORTH.

Signed by [Signature] Date DECEMBER 19, 1994

Surveyor's Michigan License No. 28409

I-13 T1S R2W
PART A CONTINUED

3. RECORDS OF TIM VANGIESON; LS 24621, DATED DECEMBER 27, 1979 IDENTIFIES CORNER AS A FIRE CLAY AND SHOWS 4 WITNESSES: 20 NAIL IN 10" OAK, S00°W, 180.87'; 20 NAIL IN 30" OAK, S30°W, 141.65'; 20 NAIL & TAG IN 30" OAK, S45°W, 133.68' AND 20 NAIL & TAG IN 30" OAK, S85°W, 154.36'.