

Chairman *Don R. Hubbard*
 Date MAY 15, 1997

#2037790
 Liber 1544 Page 359
 Page 1 of 1
 Jackson Co., MI
 Recorded
 05/11/97 10:58A
 Mindy Reilly
 Register of Deeds

LAND CORNER RECORDATION CERTIFICATE
 Filing Requirement of Act 74, Mich. P.A. 1970

For corners in
JACKSON
 (County)

Located in: Corner Code #
 T1S R 2W J-7

1. Public Land Survey


2. Property Controlling in Section

3. Miscellaneous Property in Sec.

4. Lot No. _____, Recorded Plat _____

5. Private Claims _____

S T R
 S T R
 S T R
 S T R

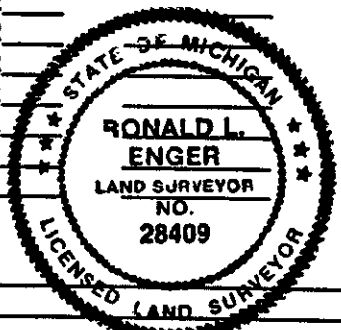

SURVEY &
 REMONUMENTATION

APR 07 1998

SECTION

Register of Deeds Stamp & File Number

	A	B	C	D	E	F	G	H	I	J	K	L	M
1													
2	6		5		4		3		2		1		
3													
4	7		8		9		10		11		12		
5													
6	18		17		16		15		14		13		
7									14				
8	19		20		21		22		23		24		
9													
10	30		29		28		27		26		25		
11													
12	31		32		33		34		35		36		
13													

I, RONALD L. ENGER, in a field survey on APRIL 18, 1997 do hereby state that under requirements of P.A. 74, Michigan P.A. of 1970, the corner points mentioned in lines 1 and 2 above were in conformance with regulations and rules therefore as required in the current manual of survey instructions of the United States Department of the Interior, Bureau of Land Management or by a decree of a Court of Law and /or that the corner points mentioned in lines 3, 4 and 5 above were in conformance with the rules of the Michigan Board of Land Surveyors or by a Decree of a Court of Law; established, re-established, monumented, recovered, found as expressed below:

NOTE: Not more than 2 corners, all in the same town and range, may be recorded on this certificate.

A. Description of original monument and accessories and/or subsequent restoration:

1. POST SET IN ORIGINAL GOVERNMENT SURVEY BY LUCIUS LYON, D.S. IN FEBRUARY, 1825 AND TWO WITNESSES RECORDED:
 BURR OAK 8 N32E 9
 BURR OAK 15 S75W 15
2. IN OCTOBER 1885 JOHN HOLCROFT REPORTED "FOUND STAKE AT CORNER(KEPT UP) AND REMAINS OF 1ST AND SECOND OLD WITNESS STANDING"
 BURR OAK 15 S15W 32½ (21.45')
 BURR OAK 15 N10W 19½ (12.87')

B. Description of corner evidence found and/or method applied in restoring or reestablishing corner:

SEARCHED AT APPARENT LOCATION OF CORNER ON APRIL 18, 1997 AND FOUND A DRAINAGE DITCH RUNNING SE TO NW AT POSITION OF CORNER. NONE OF HOLCROFT'S WITNESSES SURVIVE. TRAVERSED NORTH LINE OF SECTION 24 AND FOUND HALF WAY AND ON LINE POSITION TO FALL IN CENTER OF DRAIN ON TREE LINE NORTH SOUTH AND EAST WEST. SET ALUMINUM PIPE MONUMENT AND CAP STAMPED LS 28409 IN CENTER OF DITCH 1/2 WAY AND ON LINE BETWEEN SECTION CORNERS.

C. Description of monument for corner and accessories established to perpetuate locating the position of the corner:

J-7 T1S R2W			
3/4 INCH X 36" ALUMINUM PIPE MONUMENT AND 3" ALUMINUM CAP STAMPED LS 28409			
39° NAZ	7" HICKORY	39.65'	NAIL & TAG #28409 IN SOUTHEAST SIDE
132° NAZ	30" MAPLE	16.07'	NAIL & TAG #28409 IN SOUTHWEST SIDE
185° NAZ	20" MAPLE	67.73'	NAIL & TAG #28409 IN EAST SIDE
268° NAZ		11.8'	SURVEY MARKER SIGN POST
273° NAZ	16" ASH	29.15'	NAIL & TAG #28409 IN NORTH SIDE

NOTE: NAZ IS MAGNETIC AZIMUTH MEASURED FROM NORTH.

Signed by *Ronald L. Enger*
 Surveyor's Michigan License No. 28409

Date MAY 8, 1997