

Chairman Don Galt  
Date Dec. 20, 1994

N 1/4 CORNER SECTION 26  
TOMPKINS TOWNSHIP

LAND CORNER RECORDATION CERTIFICATE  
Filing Requirement of Act 74, Mich. P.A. 1970

For corners in


|                                    |             |                |
|------------------------------------|-------------|----------------|
| JACKSON<br>County                  | Located In: | Corner Code #: |
| 1. Public Land Survey              | T 1S R 2W   | J-9            |
| 2. Property Controlling in Section | T R         |                |
| 3. Miscellaneous Property in Sec   | T R         |                |
| 4. Lot No. Recorded Plat           | S T R       |                |
| 5. Private Claims                  | S T R       |                |

STATE OF MICHIGAN  
JACKSON COUNTY  
REGISTERED

2 MAY 95 8:21 A.M.

GERALD J. McDEVITT  
REGISTER OF DEEDS

Register of Deeds Stamp & File Number

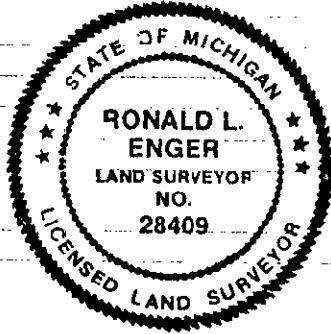

|    |    |    |    |    |    |    |   |   |   |   |   |   |   |
|----|----|----|----|----|----|----|---|---|---|---|---|---|---|
|    | A  | B  | C  | D  | E  | F  | G | H | I | J | K | L | M |
| 2  | 6  | 5  | 4  | 3  | 2  | 1  |   |   |   |   |   |   |   |
| 3  |    |    |    |    |    |    |   |   |   |   |   |   |   |
| 4  | 7  | 8  | 9  | 10 | 11 | 12 |   |   |   |   |   |   |   |
| 5  |    |    |    |    |    |    |   |   |   |   |   |   |   |
| 6  | 18 | 17 | 16 | 15 | 14 | 13 |   |   |   |   |   |   |   |
| 7  |    |    |    |    |    |    |   |   |   |   |   |   |   |
| 8  | 19 | 20 | 21 | 22 | 23 | 24 |   |   |   |   |   |   |   |
| 9  |    |    |    |    |    |    |   |   |   |   |   |   |   |
| 10 | 30 | 29 | 28 | 27 | 26 | 25 |   |   |   |   |   |   |   |
| 11 |    |    |    |    |    |    |   |   |   |   |   |   |   |
| 12 | 31 | 32 | 33 | 34 | 35 | 36 |   |   |   |   |   |   |   |
| 13 |    |    |    |    |    |    |   |   |   |   |   |   |   |

RONALD L. ENGER DECEMBER 16 1994

I, in a field survey on, do hereby certify that under requirements of P.A. 74, Michigan P.A. of 1970, the corner points mentioned in lines 1 and 2 above were in conformance with regulations and rules therefore as required in the current manual of survey instructions of the United States Department of the Interior, Bureau of Land Management or by a decree of a Court of Law and/or that the corner points mentioned in lines 3, 4 and 5 above were in conformance with the rules of the Michigan Board of Land Surveyors or by a Decree of a Court of Law; established, re-established, monumented, re-monumented, recovered, found as expressed below:

NOTE: Not more than 4 corners, all in the same town and range, may be recorded on this certificate.

A. Description of original monument and accessories and/or subsequent restoration:

1. POST SET IN ORIGINAL GOVERNMENT SURVEY BY LUCIUS LYON, DS, BETWEEN FEB 2 AND FEB 12, 1825 AND TWO BEARING TREES WERE RECORDED: BO 8 S20E 42 AND WO 16 N65W 61.

2. ON OCTOBER 8, 1885, JOHN HOLCROFT REPORTED "CORNER GONE BY DIGGING FOR SKUNKS. LOCATED CORNER BY H.F. BEAN'S WITNESSES, WHICH AGREES WITH AVERAGE DISTANCE AS MEASURED BY ME" AND RECORDED 2 WITNESSES: W. OAK 12 N3-1/2W 419 (276.5') AND Y. DO 18 S89-1/4W 468-1/2 (309.2')

B. Description of corner evidence found and/or method applied in restoring or reestablishing corner:  
CORNER FALLS IN A CORN FIELD. EXTENDED FENCE ON NORTH LINE OF WEST 1/2 OF THE NW 1/4 OF SECTION 26 TO EAST FOR DISTANCE OF 1320' FROM A FOUND PINCH PIPE AT A FENCE CORNER AT APPARENT LOCATION ON THE NE CORNER OF THE W 1/2 SAID NW 1/4 TO DETERMINE A SEARCH AREA. EXCAVATED AT STRONG MAGNETIC READING ABOUT 12' EAST AND 4' NORTH OF CENTER OF SEARCH AREA. FOUND 1/2" PIPE ON NORTH SIDE OF FIRECLAY POST ABOUT 18 INCHES DOWN. ACCEPTED THE FIRECLAY POST AS CORNER POSITION AS REMONUMENTED BY HOLCROFT FROM BEAN'S WITNESSES. REMOVED THE FIRECLAY IN PIECES AND SET STANDARD MONUMENT FOR PA 345 REMONUMENTATION IN JACKSON COUNTY IN THE SAME PLACE. LEFT THE PIPE IN PLACE. PUT THE FIRECLAY PIECES ON NORTH AND WEST SIDE OF THE MONUMENT. THE MONUMENT, PIPE AND FIRECLAY PIECES ARE 18" BELOW GROUND SURFACE TO KEEP THEM BELOW PLOW DEPTH.

\$ 2.00 REMONUMENTATION

\$ 7.00 CORNER REMONUMENTATION

C. Description of monument for corner and accessories established to perpetuate locating the position of the corner:

|  |          |  |  |
|--|----------|--|--|
| J-9 T1S R2W  |          |  |  |
| 4 INCH DIAMETER BY 36 INCH LONG CONCRETE MONUMENT AND ALUMINUM CAP LS 28409 1.5' |          |  |  |
| BELOW THE GROUND SURFACE IN CULTIVATED FIELD                                     |          |  |  |
| 7° NAZ METAL BARN  | 2358.00' |  | SOUTHWEST CORNER                               |
| 12° NAZ METAL BARN   | 2231.40' |  | SOUTHWEST CORNER                               |
| 181° NAZ 18" ELM   | 920.92'  |  | NAIL & TAG LS 28409 IN WEST SIDE               |
| 270° NAZ 1/2" PINCHED PIPE   | 1330.98' |  | AT FENCE POST (N1/16 CORNER OF NW1/4 SEC. 26)  |
| 338° NAZ 36" OAK   | 1003.00' |  | POSSIBLY THE NAIL & TAG LS 28409 IN SOUTH SIDE |

NOTE: NAZ IS MAGNETIC AZIMUTH MEASURED FROM NORTH.

Signed by Ronald L. Enger Date DECEMBER 20, 1994  
Surveyor's Michigan License No. 28409