

**JACKSON COUNTY
APPROVED LAND CORNER
P.A. 345 of 1990**

Chairman [Signature]
Date Dec 27, 1994
For corners in

**CENTER SECTION 26 TOMPKINS TOWNSHIP
LAND CORNER RECORDATION CERTIFICATE
Filing Requirement of Act 74, Mich. P.A. 1970**


LIBER 1465 PAGE 1290

JACKSON
(County)

Located In: Corner Code #

1. Public Land Survey
2. Property Controlling Section
3. Miscellaneous
4. Lot No. _____, Recorded Plat
5. Private Claims

T 1S R 2W J-10
T _____ R _____
T _____ R _____
T _____ R _____
S _____ T _____ R _____
S _____ T _____ R _____
S _____ T _____ R _____
S _____ T _____ R _____

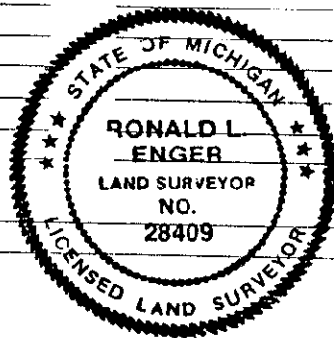

STATE OF MICHIGAN
JACKSON COUNTY
RECORDED

2 MAY 95 8:21 A.M.

GERALD J. McDEVITT
REGISTER OF DEEDS

Register of Deeds Stamp & File Number

	A	B	C	D	E	F	G	H	I	J	K	L	M
2	6	5	4	3	2	1							
3													
4	7	8	9	10	11	12							
5													
6	18	17	16	15	14	13							
7													
8	19	20	21	22	23	24							
9													
10	30	29	28	27	26	25							
11													
12	31	32	33	34	35	36							
13													

I, RONALD L. ENGER, in a field survey on AUGUST 26, 1994, do hereby certify that under requirements of P.A. 74, Michigan P.A. of 1970, the corner points mentioned in lines 1 and 2 above were in conformance with regulations and rules therefore as required in the current manual of survey instructions of the United States Department of the Interior, Bureau of Land Management or by a decree of a Court of Law and/or that the corner points mentioned in lines 3, 4 and 5 above were in conformance with the rules of the Michigan Board of Land Surveyors or by a Decree of a Court of Law; established, re-established, monumented, re-monumented, recovered, found as expressed below:

NOTE: Not more than 4 corners, all in the same town and range, may be recorded on this certificate.

A. Description of original monument and accessories and/or subsequent restoration:

1. ACT 74 LCRC FILED ON JANUARY 6, 1988 IN LIBER 5 PAGE 59; RONNIE M. LESTER, LS 18998 REPORTED THAT ON DECEMBER 7, 1987 HE "FOUND 1/2" PIPE AT FENCE INTERSECTION. FENCES NORTH, SOUTH, AND WEST. CORNER IN ACCORD WITH SURVEY BY GUTEKUNST SURVEYORS DATED 12/30/70." CORNER MARKER IS DESCRIBED AS A 1/2" PIPE AND 4 WITNESSES ARE SHOWN: SET NAIL AND TAG ON EAST SIDE 15" OAK, SSE, 23.1'; SET NAIL AND TAG ON EAST SIDE 12" ASH, SSW, 28.8'; SET NAIL AND TAG ON SOUTH SIDE 24" ASH, SW, 59.9' AND SET NAIL AND TAG ON SW SIDE 36" OAK, NW, 51.5'.

B. Description of corner evidence found and/or method applied in restoring or reestablishing corner:

SEARCHED AT APPARENT LOCATION OF CORNER AND FOUND 1/2" PIPE AT INTERSECTION OF FENCES TO NORTH, SOUTH AND WEST. ALL OF LESTER'S WITNESSES STILL EXIST AND THE PIPE IS IN GOOD RELATION TO THEM. PIPE IS 0.35' SOUTH AND 0.05' WEST OF THE INTERSECTION OF THE NORTH-SOUTH 1/4 LINE (FIRECLAY POSTS AT J-9 AND J-11) AND THE EAST-WEST 1/4 LINE (HOLCROFT'S MEMORIAL OBJECTS AT I-10 AND FIRECLAY POST AT K-10). ALL FOUR 1/4 CORNERS PREVIOUSLY APPROVED BY PA 345 PEER GROUP. ACCEPTED POSITION OF PIPE AS CENTER OF SECTION BECAUSE OF ITS AGREEMENT WITH THE OCCUPIED LINES AND ITS PROXIMITY TO THE CALCULATED INTERSECTION OF THE 1/4 LINES. REMOVED THE PIPE AND REPLACED IT WITH A BERNTSEN MODEL G-1-BR PIPE MONUMENT.

\$ 2.00 REMONUMENTATION
\$ 7.00 CORNER REMONUMENTATION

C. Description of monument for corner and accessories established to perpetuate locating the position of the corner:

1 INCH DIAMETER X 36 INCH LONG ALUMINUM PIPE MONUMENT WITH 3.25 INCH DIAMETER ALUMINUM CAP (HAS MAGNET) WITH STANDARD IMPRINT FOR PA 345 REMONUMENTATION IN JACKSON COUNTY. THE PIPE MONUMENT HAS A FLUTED CONE SHAPED POINT WHICH CONTAINS A MAGNET AND IS SUPPOSED TO SEPARATE FROM THE PIPE, LEAVING A HIGHLY MAGNETIC REMNANT AT THE CORNER POSITION, IF THE PIPE IS PULLED OUT.

006° NAZ	18" ASH	36.72'	NAIL & TAG 28409 IN WEST SIDE
173° NAZ	16" OAK	22.95'	NAIL & TAG 18998 IN EAST SIDE
217° NAZ	12" ASH	28.81'	NAIL & TAG 18998 IN EAST SIDE
253° NAZ	24" ASH	59.82'	NAIL & TAG 18998 IN SOUTH SIDE
309° NAZ	12" CHERRY	21.35'	NAIL & TAG 28409 IN NORTH SIDE
330° NAZ	36" OAK	51.65'	NAIL & TAG 18998 IN SOUTHWEST SIDE

NOTE: NAZ IS MAGNETIC AZIMUTH MEASURED FROM NORTH.

Signed by [Signature] Date DECEMBER 26, 1994

Surveyor's Michigan License No. 28409