

JACKSON COUNTY
 APPROVED LAND CORNER
 P.A. 345 of 1990

Chairman [Signature] SOUTH 1/4 CORNER SECTION 35 TOMPKINS TOWNSHIP

LIBER 1466 PAGE 3

Date Dec. 20, 1994

LAND CORNER RECORDATION CERTIFICATE
 Filing Requirement of Act 74, Mich. P.A. 1970

For corners in
JACKSON
 (County)

Located In:	Corner Code #
T 1S R 2W	J-13
T _____ R _____	_____
T _____ R _____	_____
T _____ R _____	_____
S _____ T _____ R _____	_____
S _____ T _____ R _____	_____
S _____ T _____ R _____	_____
S _____ T _____ R _____	_____

STATE OF MICHIGAN
 JACKSON COUNTY
 RECORDED
 2 MAY 95 8:23 A.M.
 GERALD J. McDEVITT
 REGISTER OF DEEDS

Register of Deeds Stamp & File Number

4. Lot No. _____, Recorded Plat _____
 5. Private Claims _____

	A	B	C	D	E	F	G	H	I	J	K	L	M
2	6	5	4	3	2	1							
3													
4	7	8	9	10	11	12							
5													
6	18	17	16	15	14	13							
7													
8	19	20	21	22	23	24							
9													
10	30	29	28	27	26	25							
11													
12	31	32	33	34	35	36							
13													

I, RONALD L. ENGER, in a field survey on DECEMBER 5, 19 94, do hereby certify that under requirements of P.A. 74, Michigan P.A. of 1970, the corner points mentioned in lines 1 and 2 above were in conformance with regulations and rules therefore as required in the current manual of survey instructions of the United States Department of the Interior, Bureau of Land Management or by a decree of a Court of Law and/or that the corner points mentioned in lines 3, 4 and 5 above were in conformance with the rules of the Michigan Board of Land Surveyors or by a Decree of a Court of Law; established, re-established, monumented, re-monumented, recovered, found as expressed below:

NOTE: Not more than 4 corners, all in the same town and range, may be recorded on this certificate.

A. Description of original monument and accessories and/or subsequent restoration:

1. JOSEPH WAMPLER, DS, ESTABLISHED CORNER IN THE ORIGINAL GOVERNMENT SURVEY IN JANUARY 1824; WO 15 N67E 42 AND BO 24 N72W 96.
2. ON OCTOBER 31, 1885, JOHN HOLCROFT REPORTED "FOUND OLD POST AND 1ST WITNESS STUMP" AND RECORDED 2 WITNESSES: HICKORY 6 N61-3/4E 6-3/4 (4.5') AND Y. OAK 5 N2-1/2E 71-1/2 (47.2')
 \$ 2.00 REMONUMENTATION
 \$ 9.00 CORNER REMONUMENTATION


CONTINUED ON BACK

B. Description of corner evidence found and/or method applied in restoring or reestablishing corner:

SEARCHED AT APPARENT LOCATION OF CORNER AND FOUND FIRECLAY 1 FOOT WEST OF ANCHOR POST IN EAST-WEST FENCE AND 1 FOOT SOUTH OF ANCHOR POST IN FENCE TO NORTH USING VANGIESEON'S WITNESSES AND HOLCROFT'S WITNESSES, ONE IS STANDING AND THE OTHER IS A STUMP. ACCEPTED FIRECLAY AS CORNER POSITION AS PERPETUATED BY HOLCROFT AND REPLACED IT WITH STANDARD MONUMENT FOR PA 345 REMONUMENTATION IN JACKSON COUNTY.

SURVEY &
 REMONUMENTATION

MAY 17 1995

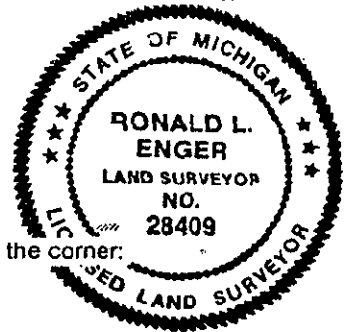

C. Description of monument for corner and accessories established to perpetuate locating the position of the corner:

J-13 T1S R2W			
4 INCH DIAMETER BY 36 INCH LONG CONCRETE MONUMENT AND ALUMINUM CAP LS 28409			
047° NAZ 28" HICKORY	4.66'		SPIKE & TAG PS 28409 IN NW SIDE
014° NAZ 10" HICKORY	27.08'		SPIKE & TAG PS 28409 IN WEST SIDE
103° NAZ 19" OAK	21.40'		SPIKE & TAG PS 28409 IN NORTH SIDE
218° NAZ 8" HICKORY	41.09		SPIKE & TAG PS 28409 IN NW SIDE
234° NAZ 11" CHERRY	59.10		SPIKE & TAG PS 28409 IN EAST SIDE

NOTE: NAZ IS MAGNETIC AZIMUTH MEASURED FROM NORTH.

Signed by [Signature] Date DECEMBER 2, 1994
 Surveyor's Michigan License No. 28409

J-13 T1S R2W
PART A CONTINUED

3. RECORDS OF TIM VANGIESON, LS 24621, DATED DECEMBER 27, 1979 IDENTIFY CORNER AS A FIRE CLAY AND SHOW 4 WITNESSES: 20 NAIL IN 10" ASH, N05°E, 32.64'; 20 NAIL IN 36" OAK, N45°E, 4.30'; 20 NAIL IN 18" OAK S85°E, 21.40' AND 20 NAIL IN 10" CHERRY, S60°W, 59.10'.