

**JACKSON COUNTY
APPROVED LAND CORNER
P.A. 345 of 1990**

CENTER OF SECTION 36
TOMPKINS TOWNSHIP

Chairman Dean R. [Signature]
Date Dec. 13, 1995

LAND CORNER RECORDATION CERTIFICATE LIBER 1501 PAGE 1067
Filing Requirement of Act 74, Mich. P.A. 1970

For corners in

JACKSON (County) Located In: Corner Code #


1. Public Land Survey T 1S R 2W L-12
T R
T R
T R

2. Property Controlling S T R
in Section S T R

3. Miscellaneous S T R
Property in Sec. S T R

4. Lot No. _____, Recorded Plat _____

5. Private Claims _____

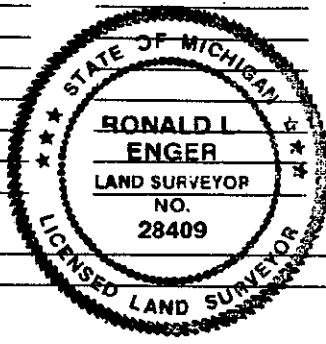

STATE OF MICHIGAN
JACKSON COUNTY
RECORDED
29 DEC 95 10:25 A.M.
GERALD J. McDEVITT
REGISTER OF DEEDS
Register of Deeds Stamp & File Number

	A	B	C	D	E	F	G	H	I	J	K	L	M
2	6		5		4		3		2		1		
3													
4	7		8		9		10		11		12		
5													
6	16		17		16		15		14		13		
7													
8	19		20		21		22		23		24		
9													
10	30		29		28		27		26		25		
11													
12	31		32		33		34		35		36		
13													

I, RONALD L. ENGER, in a field survey on DECEMBER 19, 1994, do hereby certify that under requirements of P.A. 74, Michigan P.A. of 1970, the corner points mentioned in lines 1 and 2 above were in conformance with regulations and rules therefore as required in the current manual of survey instructions of the United States Department of the Interior, Bureau of Land Management or by a decree of a Court of Law and/or that the corner points mentioned in lines 3, 4 and 5 above were in conformance with the rules of the Michigan Board of Land Surveyors or by a Decree of a Court of Law, established, re-established, monumented, re-monumented, recovered, found as expressed below:

NOTE: Not more than 4 corners, all in the same town and range, may be recorded on this certificate.

A. Description of original monument and accessories and/or subsequent restoration:

1. A SURVEY BY TIM VANGIESON, LS 24621, DATED DECEMBER 20, 1990, IDENTIFIES THE CORNER AS A 3/4" X 36" PIPE AND SHOWS 4 WITNESSES:
60D IN 8" CHERRY S 18°E 26.22'
60D IN 8" OAK S 04°W 31.35'
60D IN 15" ELM S 35°W 40.79'
60D IN 15" OAK N 43°W 12.35'

REMONUMENTATION
FEB 22 1996
COMMISSION

B. Description of corner evidence found and/or method applied in restoring or reestablishing corner:

SEARCHED AT APPARENT LOCATION OF CORNER AND FOUND 3/4" PIPE WITH CAP TVG 24621 ONE FOOT SOUTH OF EAST-WEST FENCE AND NEAR NORTH-SOUTH TREE LINE. PROVED PIPE WITH CAP TO BE IN POSITION INDICATED BY VAN GIESON'S WITNESSES BY THE 8" CHERRY (NOW 10") AT S18E AND THE 8" OAK (NOW 12") AT S04W. TIM VAN GIESON TOLD ME THAT HE INTENDED TO ESTABLISH THIS CENTER OF SECTION AT THE INTERSECTION OF 1/4 LINES. FOUND PIPE AND CAP IS 0.60' SOUTH AND 0.19' EAST OF OUR CALCULATION OF THE INTERSECTION OF THE 1/4 LINES (THE FOUR RELEVANT 1/4 CORNERS ARE ALL FIRECLAY POSTS). ACCEPTED THE POSITION OF VAN GIESON'S PIPE AS CENTER OF SECTION BECAUSE IT WAS ESTABLISHED BY THE PROPER PROCEDURE BY A LICENSED SURVEYOR. REPLACED THE PIPE WITH STANDARD MONUMENT FOR PA 345 REMONUMENTATION IN JACKSON COUNTY.

\$ 2.00 REMONUMENTATION
\$ 7.00 CORNER REMONUMENTATION

C. Description of monument for corner and accessories established to perpetuate locating the position of the corner:

L-12 T1S R2W
4 INCH DIAMETER BY 36 INCH LONG CONCRETE MONUMENT AND ALUMINUM CAP LS 28409
040° NAZ 5" MAPLE 19.34 NAIL AND TAG LS #28409 IN W SIDE
162° NAZ 10" CHERRY (TVG) 26.22 60D SPIKE IN W SIDE
184° NAZ 12" OAK (TVG) 31.33 60D SPIKE IN W SIDE
220° NAZ 16" HICKORY 47.80 60D SPIKE IN W SIDE
337° NAZ 8" HICKORY 28.32 NAIL AND TAG LS #28409 IN E SIDE

NOTE: NAZ IS MAGNETIC AZIMUTH FROM THE NORTH.

Signed by Ronald L. Enger Date DECEMBER 12, 1995
Surveyor's Michigan License No. 28409