

JACKSON COUNTY
APPROVED LAND CORNER
P.A. 344 of 1990

Chairman Dean K. Hathorn
Date Dec. 20, 1994

SOUTH 1/4 CORNER SECTION 36
TOMPKINS TOWNSHIP

LIBER 1466 PAGE

LAND CORNER RECORDATION CERTIFICATE
Filing Requirement of Act 74, Mich. P.A. 1970

For corners in

JACKSON
(County)

Located In:

Corner Code #

- | | | | | | |
|--|---|-----------|---|-----------|-------------|
| 1. Public Land Survey | T | <u>1S</u> | R | <u>2W</u> | <u>L-13</u> |
| | T | _____ | R | _____ | _____ |
| | T | _____ | R | _____ | _____ |
| | T | _____ | R | _____ | _____ |
| 2. Property Controlling
in Section <u>MAY 17 1995</u> | S | _____ | T | _____ | _____ |
| | S | _____ | T | _____ | _____ |
| 3. Miscellaneous
Property in Sec. <u>COMMISSION</u> | S | _____ | T | _____ | _____ |
| | S | _____ | T | _____ | _____ |
| 4. Lot No. _____, Recorded Plat _____ | T | _____ | R | _____ | _____ |
| 5. Private Claims _____ | T | _____ | R | _____ | _____ |

STATE OF MICHIGAN
JACKSON COUNTY
RECORDED

2 MAY 95 8:24 A.M.

GERALD J. McDEVITT
REGISTER OF DEEDS

Register of Deeds Stamp & File Number

I, RONALD L. ENGER in a field survey on NOVEMBER 3, 19 94, do hereby certify that under requirements of P.A. 74, Michigan P.A. of 1970, the corner points mentioned in lines 1 and 2 above were in conformance with regulations and rules therefore as required in the current manual of survey instructions of the United States Department of the Interior, Bureau of Land Management or by a decree of a Court of Law and/or that the corner points mentioned in lines 3, 4 and 5 above were in conformance with the rules of the Michigan Board of Land Surveyors or by a Decree of a Court of Law; established, re-established, monumented, re-monumented, recovered, found as expressed below:

NOTE: Not more than 4 corners, all in the same town and range, may be recorded on this certificate.

A. Description of original monument and accessories and/or subsequent restoration:

- POST SET IN ORIGINAL GOVERNMENT SURVEY BY JOSEPH WAMPLER, DS, IN JANUARY 1824, BO 24 N51-1/2W 47 AND WO 27 N3-1/2W 40.
- ON NOVEMBER 28, 1885, JOHN HOLCROFT REPORTED "CORNER GONE. FOUND REMAINS OF 1ST WITNESS AND STUMP OF 2ND WITNESS STANDING" AND RECORDED 2 WITNESSES: SASSAFRAS 6 N0-3/4E 20 (13.2') AND HICKORY 5 N87E 84 (55.4')

CONTINUED ON BACK

\$ 2.00 REMONUMENTATION
\$ 9.00 CORNER REMONUMENTATION

B. Description of corner evidence found and/or method applied in restoring or reestablishing corner:

SEARCHED AT APPARENT LOCATION OF CORNER AND FOUND 1" AXLE SHAFT 4' EAST OF NORTH-SOUTH FENCE ON NORTH-SOUTH TREE LINE AND TREE LINE TO EAST. EXCAVATED ALL AROUND AXLE AND AT A DEPTH OF 4', FOUND FIRECLAY ON NORTHWEST SIDE OF AXLE. SET STANDARD MONUMENT FOR PA 345 REMONUMENTATION IN JACKSON COUNTY ON TOP OF FIRECLAY AND LEFT AXLE IN PLACE AS WE COULD NOT GET IT OUT.

C. Description of monument for corner and accessories established to perpetuate locating the position of the corner:


- L-13 T1S R2W
- | | | |
|---|--------------------|--------|
| 4 INCH DIAMETER BY 36 INCH LONG CONCRETE MONUMENT AND ALUMINUM CAP LS 28409 | | |
| 0° NAZ | 8" HICKORY | 83.30' |
| 91° NAZ | 17" SASSAFRAS | 18.59' |
| 135° NAZ | 1" AXLE SHAFT | 0.15' |
| 181° NAZ | 18" SASSAFRAS | 10.25' |
| 270° NAZ | 4" X 4" FENCE POST | 9.57' |
- NAIL AND TAG LS 25837 IN S. SIDE
NAIL AND TAG LS 25837 IN EAST SIDE
NAIL AND TAG LS 25837 IN E. SIDE
(GUTEK UNST'S WITNESS)
NAIL AND TAG LS 25837 IN S. SIDE

NOTE: NAZ IS MAGNETIC AZIMUTH MEASURED FROM NORTH.

Signed by Ronald L. Enger

Date DECEMBER 8, 1994

Surveyor's Michigan License No. 28409

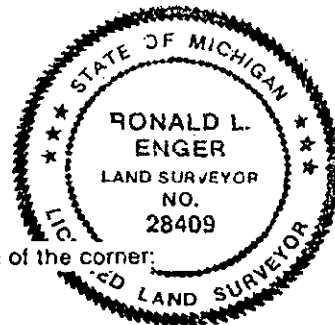

L-13 T1S R2W
PART A CONTINUED

3. ACT 74 LAND CORNER RECORDATION CERTIFICATE (LIBER 2 PAGE 349) FILED BY RICHARD E. GUTEKUNST, RLS 7863 ON NOVEMBER 21, 1973 STATES "FOUND 1" SOLID IRON, SURROUNDED WITH ROCKS" AND SHOWS 3 WITNESSES: EAST, HICKORY, 99.86; NORTH, 10" SASSAFRAS, 18.65' AND SOUTH, 12" SASSAFRAS, 10.30' AND "4.3' EAST OF NORTH AND SOUTH FENCE AND IN LINE WITH OLD FENCE EAST".