

Chairman Dean R. Gutekunst
 Date April 14, 1999

LAND CORNER RECORDATION CERTIFICATE
 Filing Requirement of Act 74, Mich. P.A. 1970

MAR 13 2000

For corners in
JACKSON
 (County)

Located In: Corner Code #

SECTION

- | | | | | | | | |
|------------------------------------|---|---|---|---|---|---|------|
| 1. Public Land Survey | T | 1 | S | R | 3 | W | J-11 |
| | T | | R | | | | |
| | T | | R | | | | |
| | T | | R | | | | |
| 2. Property Controlling in Section | S | | T | R | | | |
| | S | | T | R | | | |
| 3. Miscellaneous Property in Sec. | S | | T | R | | | |
| | S | | T | R | | | |




2139078
 Page: 1 of 2
 12/06/1999 03:28P
 L-1618 P-942

Register of Deeds Stamp & File Number

4. Lot No. _____ Recorded Plat _____
 5. Private Claims _____

I, DEAN R. GUTEKUNST, in a field survey on 5/20/97 & 8/13/97 & July 15, 1998, do hereby certify that under requirements of P.A. 74, Michigan P.A. of 1970, the corner points mentioned in lines 1 and 2 above were in conformance with regulations and rules therefore as required in the current manual of survey instructions of the United States Department of the Interior, Bureau of Land Management or by a decree of a Court of Law and/or that the corner points mentioned in lines 3, 4 and 5 above were in conformance with the rules of the Michigan Board of Land Surveyors or by a Decree of a Court of Law; established, re-established, monumented, re-monumented, recovered, found as expressed below:

NOTE: Not more than 4 corners, all in the same town and range, may be recorded on this certificate.

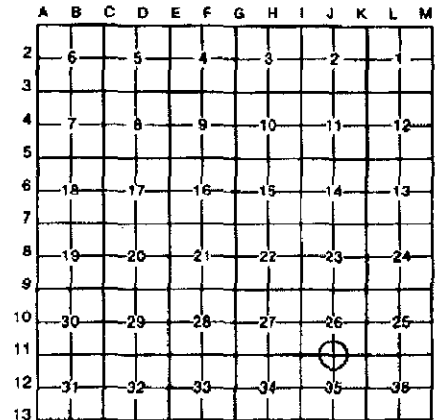

A. Description of original monument and accessories and/or subsequent restoration:

Original Government Post set by Lucius Lyon, Deputy Surveyor, April 1825.
 W. Oak 12" N 55 E 23 links (15.18')
 W. Oak 6" S 55 E 33 links (21.78')

No perpetuation found for the 1880's.

Continued on back,



B. Description of corner evidence found and/or method applied in restoring or reestablishing corner:

Found 3/4" solid rod, 3' South of center line of gravel road, and in line of occupation South
 Backhoe excavation, by Jackson County Road Commission, did not reveal any additional evidence of corner.
 Corner is approximately 5' South of center line of blacktop (Town Road) and in line of occupation South.
 Accepted found rered as the best available evidence of the position of the original corner.
 Set a Standard Jackson County Monument to replace the rered.

C. Description of monument for corner and accessories established to perpetuate locating the position of the corner:

J-11 T1S, R3W Corner is a 4" diameter X 30" Cast Iron Harrison monument with a Brass cap stamped LS 18658, which is a standard monument for Jackson County.

* N 55 E	28" Walnut	60.67'	Found 60d spike on South side.
S 75 W	11" Hickory	73.24'	Pole barn spike and washer on South side.
S 20 E	11" Locust	42.75'	Pole barn spike and washer on East side.
N 15 W	21" Walnut	105.08'	Pole barn spike and washer on East side.
N 55 W	6" Hickory	120.60'	Pole barn spike and washer on Southwest side.

South Steel post and survey marker sign attached 23'
 Monument box set over monument by Jackson County Road Commission.

April 1, 1999

Signed by Dean R. Gutekunst Date _____
 Surveyor's Michigan License No. 18658

Continued,

A.)



2139078
Page: 2 of 2
12/06/1999 09:28P
L-1618 P-942

Perpetuation by Robert E. Sayers, RLS #7874, dated March 13, 1972.
Found 1/2" bar in N & S fence line.

N 35 W PK in 40" stump 21.20'
South PK in 12" stump 15.20'

**SURVEY &
REMONUMENTATION**

MAR 13 2000

SECTION

Perpetuation by Timothy B. VanGieson, RLS #24621, dated January 21, 1994.
5/8" rod

* 60-d in 24" Walnut	N 56 E	60.55'	
** 60-d in 40" Oak	S 54 E	38.77'	(stump 8/13/97) - NOW GONE
60-d in 16" Ash	S 23 W	34.93'	
60-d in 12" Hickory	S 76 W	63.47'	(stump 8/13/97)

Not recorded in P.A. - 74.