

**JACKSON COUNTY
APPROVED LAND CORNER
P.A. 345 of 1990**

Chairman David E. Erickson
Date DEC. 26, 1996

North 1/4 Corner of Section 4, Henrietta Township
LAND CORNER RECORDATION CERTIFICATE
Filing Requirement of Act 74, Mich. P.A. 1970

#2023488
Liber 1534 Page 19
Page 1 of 1
Jackson Co., MI
Recorded
12/26/96 11:36A
Jerry McDevitt
Register of Deeds

For corners in
JACKSON
(County)

Located in: _____ Corner Code # _____

1. Public Land Survey	T2S	R1E	F-1
	T	R	_____
	T	R	_____
	T	R	_____
2. Property Controlling in Section	S	T	R
	S	T	R
	S	T	R
3. Miscellaneous Property in Sec.	S	T	R
	S	T	R
	S	T	R

4. Lot No. _____, Recorded Plat _____
5. Private Claims _____

Register of Deeds Stamp & File Number

	A	B	C	D	E	F	G	H	I	J	K	L	M
1													
2	6	5	4	3	2	1							
3													
4	7	8	9	10	11	12							
5													
6	18	17	16	15	14	13							
7													
8	19	20	21	22	23	24							
9													
10	30	29	28	27	26	25							
11													
12	31	32	33	34	35	36							
13													

I, David E. Erickson, in a field survey on June 17, 19 96, do hereby certify that under requirements of P.A. 74, Michigan P.A. of 1970, the corner points mentioned in lines 1 and 2 above were in conformance with regulations and rules therefore as required in the current manual of survey instructions of the United States Department of the Interior, Bureau of Land Management or by a decree of a Court of Law and/or that the corner points mentioned in lines 3, 4 and 5 above were in conformance with the rules of the Michigan Board of Land Surveyors or by a Decree of a Court of Law; established, re-established, monumented, re-monumented, recovered, found as expressed below:

NOTE: Not more than 4 corners, all in the same town and range, may be recorded on this certificate.

A. Description of original monument and accessories and/or subsequent restoration:

Corner not established in original GLO survey, nor subsequently by H.F. Bean in 1888.

In 1988, R.L. Lester - LS #18998, recorded the corner as "Set 1/2" bar and identification cap midway between E-1 and G-1 on township line. Corner falls 5.8' North of South edge of asphalt on Root Station Road. No occupation North or South" per Land Corner Recordation Certificate (LCRC) recorded at Liber 4, Page 82.

B. Description of corner evidence found and/or method applied in restoring or reestablishing corner:

On 1-5-96, Found illegible capped iron (Lester's) at surface of road.

On 5-6-96, excavated 13' long x 8' deep x 4 1/2' wide hole. Dug through old road bed. Nothing else found. No occupation to South. Established corner midway between corners E-1 and G-1 and on township line between corners E-13 and F-13. Position is essentially the same as Lester's, Varying slightly due to a different position for corner F-13. Set a standard Jackson County Survey Monument (JCSM) on 6-17-96.


C. Description of monument for corner and accessories established to perpetuate locating the position of the corner:

Set 4" diameter x 36" concrete monument with 1/2" x 36" rebar and Jackson County standard aluminum cap stamped "LS #29245, F-1", 1996".

N 70° W	Set nail and tag #29245, South side power pole #520	138.74'
N 75° E	Set nail and tag #29245, Southeast side 10" Oak	135.16'
S 63° E	Set nail and tag #29245, Southwest side 6" Hickory	82.52'
S 38° E	Set nail and tag #29245, Northeast side 8" Cherry	43.26'
South	County Surveyor sign post	18.1'

NOTE: Above bearings are magnetic.

Easterly	Corner "F-13", T1S-R1E, JCSM	81.20'
Westerly	Corner "E-1", JCSM	2646.48'
Easterly	Corner "G-1", JCSM	2646.48'

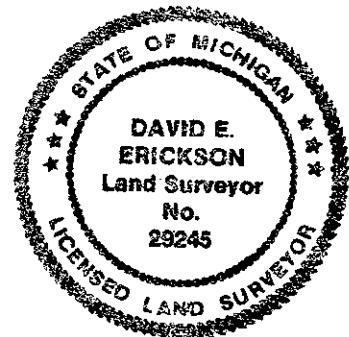

Signed by David E. Erickson Date 12-23-96

Surveyor's Michigan License No. 29245