

David E. Erickson
MAR 11, 1998

Southwest Corner of Section 34, Leoni Township
LAND CORNER RECORDATION CERTIFICATE
Filing Requirement of Act 74, Mich. P.A. 1970

#2064442
Liber 1563 Page 988
Page 1 of 1
Jackson Co., MI
Recorded
03/12/1998 12:00P
Hinda Reilly
Register of Deeds

For corners in
JACKSON
(County) Located In: Corner Code #

1. Public Land Survey T2S R1E G-13
T R
T R
T R

2. Property Controlling in Section S T R
S T R

3. Miscellaneous Property in Sec. S T R
S T R

4. Lot No. _____ Recorded Plat _____

5. Private Claims _____

SURVEY &
REMONUMENTATION

SEP 16 1998

Register of Deeds Stamp & File Number

SECTION

	A	B	C	D	E	F	G	H	I	J	K	L	M
1													
2	6	5	4	3	2	1							
3													
4	7	8	9	10	11	12							
5													
6	18	17	16	15	14	13							
7													
8	19	20	21	22	23	24							
9													
10	30	29	28	27	26	25							
11													
12	31	32	33	34	35	36							
13													

I, David E. Erickson, in a field survey on July 11, 19 97, do hereby certify that under requirements of P.A. 74, Michigan P.A. of 1970, the corner points mentioned in lines 1 and 2 above were in conformance with regulations and rules therefor as required in the current manual of survey instructions of the United States Department of the Interior, Bureau of Land Management or by a decree of a Court of Law and/or that the corner points mentioned in lines 3, 4 and 5 above were in conformance with the rules of the Michigan Board of Land Surveyors or by a Decree of a Court of Law; established, re-established, monumented, re-monumented, recovered, found as expressed below:

NOTE: Not more than 4 corners, all in the same town and range, may be recorded on this certificate.

A. Description of original monument and accessories and/or subsequent restoration:

In 1825, H. Parke - Deputy Surveyor, reported "Post" and recorded two witnesses: "W. Oak 14, S54°E, 32" (21.12') and "do 10, N30°W, 8" (5.28').

Between 1886 and 1888, H.F. Bean reported "Post out, One witness left" and recorded two witnesses: "Hickory 12, S31°W, 40" (26.40') and "W. Oak 28, S10°E, 51 1/2" (33.99').

Not recorded under PA 74 of 1970.

B. Description of corner evidence found and/or method applied in restoring or reestablishing corner:


Found fireclay (FC) at surface, leaning Northeasterly, pushed by tree roots. A pinch pipe and 3/4" iron pipe with cap "REG 7863" are on North side. Also found 2 pieces of pottery below FC. Accepted found FC as a careful and faithful perpetuation of the original corner. Straightened FC, removed and replaced with a standard Jackson County concrete monument. Buried FC, irons and pottery on North side of monument.

C. Description of monument for corner and accessories established to perpetuate locating the position of the corner:

Set precast concrete monument with 1/2" rebar and Jackson County standard aluminum cap stamped "T2S-R1E, G-13, 29245, 1997".

S 50° E	Set nail and tag #29245, West side 15" Sassafras	2.17'
S 33° E	Set nail and tag #29245, West side 34" Oak	31.95'
S 65° W	Set nail and tag #29245, South side 20" Oak	15.50'
N 42° W	Set nail and tag #29245, West side 15" Oak	30.00'
South	County Surveyor sign post	0.5'

NOTE: Bearings are magnetic.

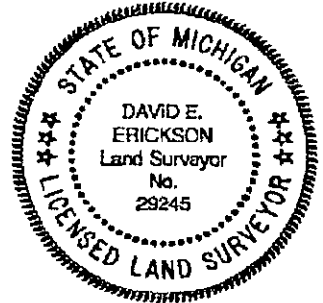

Signed by David E. Erickson Date 3-11-98

Surveyor's Michigan License No. 29245

FORM APPROVED BY MICHIGAN STATE BOARD OF LAND SURVEYORS, JAN. 28, 1971