

JACKSON COUNTY
APPROVED LAND CORNER

P.A. 345 of 1990

Chairman David E. Erickson

Date Dec 26, 1996

North 1/4 Corner of Section 3, Henrietta Township

LAND CORNER RECORDATION CERTIFICATE

Filing Requirement of Act 74, Mich. P.A. 1970

#2023491
Liber 1534 Page 22
Page 1 of 1
Jackson Co., MI
Recorded
12/26/96 11:37A
Jerry McDewitt
Register of Deeds

For corners in
JACKSON
(County) Located In: Corner Code #

1. Public Land Survey T2S R1E H-1
T R
T R
T R
2. Property Controlling in Section S T R
S T R
3. Miscellaneous Property in Sec. S T R
S T R

4. Lot No. _____ Recorded Plat _____
5. Private Claims _____

Register of Deeds Stamp & File Number

	A	B	C	D	E	F	G	H	I	J	K	L	M
1													
2	6	5	4	3	2	1							
3													
4	7	8	9	10	11	12							
5													
6	18	17	16	15	14	13							
7													
8	19	20	21	22	23	24							
9													
10	30	29	28	27	26	25							
11													
12	31	32	33	34	35	36							
13													

I, David E. Erickson, in a field survey on April 17, 19 96, do hereby certify that under requirements of P.A. 74, Michigan P.A. of 1970, the corner points mentioned in lines 1 and 2 above were in conformance with regulations and rules therefore as required in the current manual of survey instructions of the United States Department of the Interior, Bureau of Land Management or by a decree of a Court of Law and/or that the corner points mentioned in lines 3, 4 and 5 above were in conformance with the rules of the Michigan Board of Land Surveyors or by a Decree of a Court of Law, established, re-established, monumented, re-monumented, recovered, found as expressed below:

NOTE: Not more than 4 corners, all in the same town and range, may be recorded on this certificate.

A. Description of original monument and accessories and/or subsequent restoration:

Corner not established in original 1825 survey by H. Parke - Deputy Surveyor, nor subsequently by H. F. Bean in 1888.

Nothing of record indicating this corner has ever been established in the field.

B. Description of corner evidence found and/or method applied in restoring or reestablishing corner:


Excavated a 4' diameter x 2' deep hole centered on a single-proportionate position for this corner. Nothing found. No occupation in any direction. Corner falls in low marshy area, probably was once a muck field. Established corner on Township line between corners G-13 and H-13 (T1S-R1E), midway between corners G-1 and I-1. Set 60" aluminum pipe with cap, up 0.5'.

C. Description of monument for corner and accessories established to perpetuate locating the position of the corner:

Set 60" aluminum pipe with Jackson County Standard Aluminum Cap stamped "LS #29245, H-1, T2S, R1E, 1996".

S 82° E	Corner H-13, T1S-R1E, Aluminum Pipe	74.80'
S 85° W	Set nail & tag #29245, North side 28" Cottonwood	360.26'
N 44° W	Set nail & tag #29245, South side 40" Cottonwood	303.73'
S 08° W	Set nail & tag #29245, Southeast side of limb on Boxelder Clump	374.68'
N 89° E	Set nail & tag #29245, South side 6" Boxelder at North toe of berm	361.06'
North	County Surveyor sign post	1.0'
Westerly	Corner "G-1", JCASM	2678.00'
Easterly	Corner "I-1", Aluminum Pipe	2678.00'

NOTE: Above bearings are magnetic.

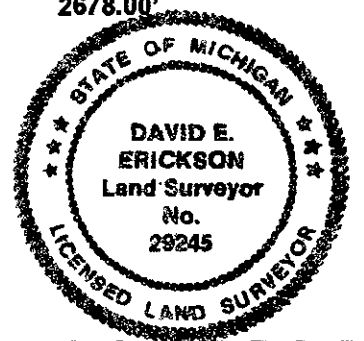

Signed by David E. Erickson Date 12-24-96

Surveyor's Michigan License No. 29245

FORM APPROVED BY MICHIGAN STATE BOARD OF LAND SURVEYORS, JAN. 25, 1971

REVISED MAY 14, 1975
REVISED JAN, 1983
ADAPTED FOR WORD PROCESSING MARCH, 1985