

STATE OF MICHIGAN
DEPARTMENT
OF
NATURAL RESOURCES

LAND CORNER RECORD


G-17 JACKSON COUNTY
T 25 R 1W

DESCRIPTION OF CORNER S.E. CORNER SEC. 16

CORNER MONUMENT MONUMENT BOX @ PARNELL RD.

DATE MONUMENT ~~PLACED~~ WITNESSED 10/9/69

WITNESSES TO CORNER..... 5" ASH 538.61'

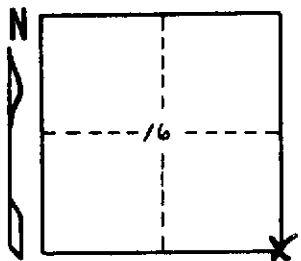

18" Elm S30°W 33.11'

15" Elm N48°E 46.82'

AND
8" WALNUT N4°E 23.68'

CIRCLE CORNER REGISTERED

DESCRIPTION IN DETAIL AS TO HOW CORNER WAS LOCATED AND IDENTIFIED OR RESTORED.

WITNESSES FURNISHED BY CONSUMERS 10/9/69.

SURVEYOR'S SEAL

SIGNED *[Signature]* DATE Oct 69
REGISTERED LAND SURVEYOR

DISTRIBUTION:

County Courthouse
Area Forester (Regions I & II)
District or Region Surveyor
Forestry Div., Lansing