
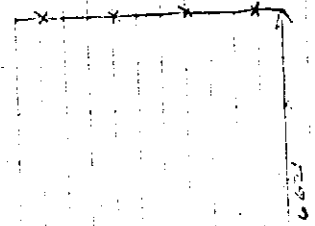


12/21/50
35° 20' 17"

SEE JACKSON Co
MISC # 6

No. Col.
Bureau of Reclamation


10 = 151° 30' 00"
20 = 3° 15'
Mean = 151° 37' 30"

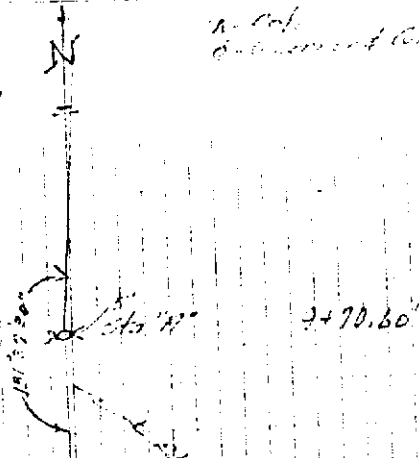

TOWN CORNER
T 1-2 S, R 1-2 E
DQR 1992

My Mag. 7" 25849 to 18" 10000 in 5 sets, used stunner
A-1 Top. Cor. 0+00

18" Elm 88° 32' 76.62'
4-8" Elm 104° 26' 77.00'
4" Maple 11° 55' 78.34'
10 = 89° 13' 30"
20 = 17° 27'

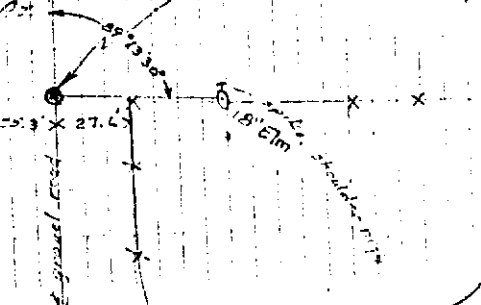

Note: see notes by Soll (book 1, p 33)
Found wagon axle set by F. J. W. Soll on 10-7-35
(to west)
Top was bent over 11" from plumb. Set a track
spike over axle, on plumb, about 5' under ground