



T2S - R2E

5667

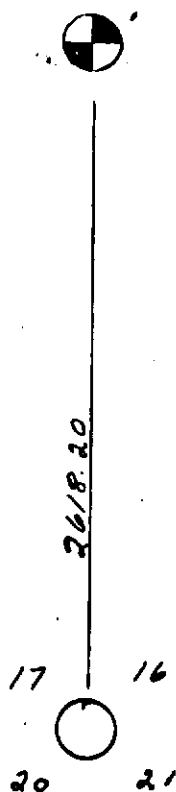

T. 2S R. 2E 38103 C
Grass Lake TWP

SEC. NO. 17

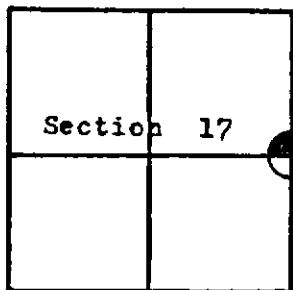

DESCRIPTION

Found 1/2" Pipe for the East X corner s
section 17 Grass Lake TWP, Jackson
County.

WITNESSES
19" Trip. W. Cherry S23W 21.79
11" W. cherry S09W 38.35
At North side of Rail-road Tie
anchor post.

1/2" pipe N side of
R.R. Anchor Post.
11" W. cherry
19" Trip. W. cherry

GOV'T. MONUMENT WITNESSES RECORD

Form 280
(Rev. 3/60)

C.E.smith
SURVEY CHIEF

April 1967
E.C.

MICHIGAN STATE HIGHWAY DEPARTMENT

DATE