

LAND CORNER RECORDATION CERTIFICATE

FILING REQUIREMENT OF ACT 74, MICH. P.A.1970

FOR CORNERS OF--:	LOCATED IN--:	CORNER CODE NUMBER
1. PUBLIC LAND SURVEY, <u>11</u> T. <u>2</u> S., R. <u>2</u> E.		<u>K-3</u>
2. PROPERTY CONTROLLING IN SECTION _____, T. _____, S., R. _____, E. _____, W. _____		
3. MISCELLANEOUS PROPERTY IN SECTION _____, T. _____, S., R. _____, E. _____, W. _____		
4. LOT NO. _____, RECORDED PLAT _____		
5. PRIVATE CLAIMS _____		

REGISTER OF DEEDS STAMP AND FILING NUMBER

I, Thomas G. Moran, do hereby certify that under requirements of P.A. 74, Michigan P.A. of 1970, the corner points mentioned in lines 1 and 2 above were, in a field survey on April, 1981, established, re-established, monumented, re-monumented, recovered or restored as expressed below and in conformance with regulations and rules therefore as required in the current manual of survey instructions of the United States Department of the Interior, Bureau of Land Management or by a decree of a court of law. Furthermore, that the corner points mentioned in lines 3, 4 and 5 above were, in a field survey on _____, 19____, found, recovered, restored, established or re-established as expressed below and in conformance with the rules of the Michigan State Board of Registration for Land Surveyors or, by a Decree of a Court of law:

A. Description of original monument and accessories and/or subsequent restoration:

B. Description of corner evidence found and/or method applied in restoring or re-establishing corner:


K-3 Found 3/4" iron pipe from 1972 DNR Survey replaced pipe with 4"x 36" concrete monument. Did not rewitness old witnesses, are listed in Part C.

C. Description of monument for corner and accessories established to perpetuate locating the position of the corner:

K-3 4"x 36" Concrete Monument
 S 66° E, 5.76', 9" Oak
 N 20° E, 12.38', 16" Oak
 S 28° E, 16.30', 15" Oak
 S 04° W, 22.96', 13" Oak

SIGNED BY Thomas G. Moran DATE 5-11-81

SURVEYOR'S MICHIGAN REGISTRATION NO. 25860

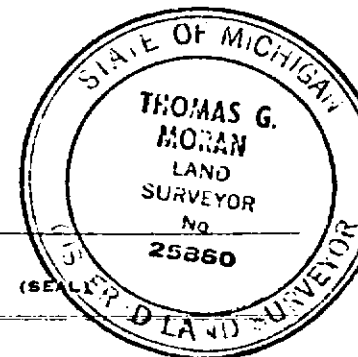

FOR STATE AND UNITED STATES AGENCIES:

SIGNED BY _____ DATE _____
CHIEF OF SURVEY PARTY

APPROVED AND SIGNED BY _____ DATE _____
MICHIGAN REGISTERED LAND SURVEYOR

(SEAL)

SURVEYOR'S MICHIGAN REGISTRATION NO. _____