

**JACKSON COUNTY
APPROVED LAND CORNER
P.A. 345 of 1990**

SOUTHEAST CORNER, SECTION 18
SANDSTONE TOWNSHIP

LIBER **1482** PAGE **642**

Acting Chairman Dean R. Guterkunst

LAND CORNER RECORDATION CERTIFICATE
Filing Requirement of Act 74, Mich. P.A. 1970

STATE OF MICHIGAN
JACKSON COUNTY
RECORDED

Date 12-30-94

17 AUG 95 9:57 A.M.

GERALD J. McDEVITT
REGISTER OF DEEDS

For corners in
JACKSON

(County)

Located In:

Corner Code #

- | | | | |
|---------------------------------------|--------------|--------------|------------|
| 1. Public Land Survey | T <u>2</u> S | R <u>2</u> W | <u>C-7</u> |
| | T _____ | R _____ | _____ |
| | T _____ | R _____ | _____ |
| | T _____ | R _____ | _____ |
| 2. Property Controlling in Section | S _____ | T _____ | R _____ |
| | S _____ | T _____ | R _____ |
| 3. Miscellaneous Property in Sec. | S _____ | T _____ | R _____ |
| | S _____ | T _____ | R _____ |
| 4. Lot No. _____, Recorded Plat _____ | | | |
| 5. Private Claims _____ | | | |

Register of Deeds Stamp & File Number

I, DEAN R. GUTEKUNST, in a field survey on December 8, 19 93, do hereby certify that under requirements of P.A. 74, Michigan P.A. of 1970, the corner points mentioned in lines 1 and 2 above were in conformance with regulations and rules therefore as required in the current manual of survey instructions of the United States Department of the Interior, Bureau of Land Management or by a decree of a Court of Law and/or that the corner points mentioned in lines 3, 4 and 5 above were in conformance with the rules of the Michigan Board of Land Surveyors or by a Decree of a Court of Law; established, re-established, monumented, re-monumented, recovered, found as expressed below:

	A	B	C	D	E	F	G	H	I	J	K	L	M
2	6		5		4		3		2		1		
3													
4	7		8		9		10		11		12		
5													
6	18		17		16		15		14		13		
7													
8	19		20		21		22		23		24		
9													
10	30		29		28		27		26		25		
11													
12	31		32		33		34		35		36		
13													

NOTE: Not more than 4 corners, all in the same town and range, may be recorded on this certificate.

A. Description of original monument and accessories and/or subsequent restoration:

Original Government Post set by Lucius Lyon, Deputy Surveyor, January 1825
 White Oak 13" S 37 E 53 links (34.98')
 Hickory 10" N 61 W 42 links (27.72')
 Perpetuation by H, F, Bean, date unknown
 (*) Hickory 1" N 74 W 11 links (7.26')

Not recorded in P. A. 74

B. Description of corner evidence found and/or method applied in restoring or reestablishing corner:

Found a 3/8" x 5' iron rod and a cultivator point, from the Hickory witness above.


Corner is in line with a stone row West, and 3' West of a stone row East, and 10' South of a stone row East, No occupation to the North.

Accepted ROD as a careful and faithful perpetuation of the position of the original corner, as remonumented by H. F. Bean. Replaced the rod with a Standard Jackson County Monument and left rod beside monument.

C. Description of monument for corner and accessories established to perpetuate locating the position of the corner:

C-7 T2S, R2W Corner is a 4" diameter X 36" concrete monument with a 1/2" X 36" steel rod and an aluminum cap stamped LS 18658, which is the standard monument for Jackson County.

(*) N 74° W	30" Hickory	7.05'	40d & washer on North side
South	36" Oak	60.95'	40d & washer on West side
N 75° E	14" Hickory	63.22'	40d & washer on North side
N 65° E	Utility Pole Fence Post	45.70'	40d & washer on North side
N 74° W	Survey marker sign		on East side of 30" Hickory

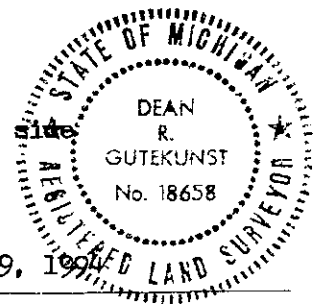

Signed by Dean R. Guterkunst Date December 29, 1994
 Surveyor's Michigan License No. 18658