

12-26-96

JACKSON COUNTY  
APPROVED LAND CORNER  
P.A. 345 of 1990

Chairman Dean R. Hubbard  
Date Dec. 26, 1996

NW CORNER SECTION 1  
SANDSTONE TOWNSHIP

LAND CORNER RECORDATION CERTIFICATE  
Filing Requirement of Act 74, Mich. P.A. 1970

#2023678  
Liber 1534 Page 198  
Page 1 of 2  
Jackson Co., MI  
Recorded  
12/27/96 12:06P  
Jerry McDewitt  
Register of Deeds

For corners in  
JACKSON  
(County)

Located In:

Corner Code #

	2S	2W	K-1
1. Public Land Survey	T	R	
	T	R	
	T	R	
	T	R	
2. Property Controlling in Section	S	T	R
	S	T	R
3. Miscellaneous Property in Sec.	S	T	R
	S	T	R

Register of Deeds Stamp & File Number

4. Lot No. \_\_\_\_\_, Recorded Plat \_\_\_\_\_  
5. Private Claims \_\_\_\_\_


	A	B	C	D	E	F	G	H	I	J	K	L	M
2	6		5		4		3		2		1		
3													
4	7		8		9		10		11		12		
5													
6	18		17		16		15		14		13		
7													
8	19		20		21		22		23		24		
9													
10	30		29		28		27		26		25		
11													
12	31		32		33		34		35		36		
13													

I, RONALD L. ENGER in a field survey on DECEMBER 20, 1996

do hereby certify that under requirements of P.A. 74, Michigan P.A. of 1970, the corner points mentioned in lines 1 and 2 above were in conformance with regulations and rules therefore as required in the current manual of survey instructions of the United States Department of the Interior, Bureau of Land Management or by a decree of a Court of Law and/or that the corner points mentioned in lines 3, 4 and 5 above were in conformance with the rules of the Michigan Board of Land Surveyors or by a Decree of a Court of Law, established, re-established, monumented, re-monumented, recovered, found as expressed below:

NOTE: Not more than 4 corners, all in the same town and range, may be recorded on this certificate.

A. Description of original monument and accessories and/or subsequent restoration:

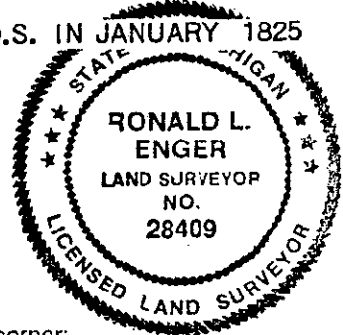

1. POST SET IN ORIGINAL GOVERNMENT SURVEY BY LUCIUS LYON D.S. IN JANUARY 1825  
"INTERSECTED NORTH BDRY. 29 LKS (19.14') WEST OF POST"  
W.O. 20" S45E 1.90  
DO 18" S10W 1.16

CONTINUED ON BACK

B. Description of corner evidence found and/or method applied in restoring or reestablishing corner:

SEARCHED AT APPARENT LOCATION OF CORNER AND FOUND 1/2" PIPE AS USED AS WITNESS TO K-13 T1S R2W IN ACT 345 CERTIFICATE IN 1994. TIED POSITION OF CORNER FROM REMONUMENTATION TRAVERSE PERFORMED IN 1994 AND ASCERTAINED THAT IT DID LIE ON THE STANDARD TOWNSHIP LINE. ACCEPTED 1/2" PIPE AS PERPETUATION OF CORNER AND REPLACED IT WITH STANDARD MONUMENT AND PILE STONES AROUND IT. CORNER FALLS ON FENCE LINE TO SOUTH AND FENCE LINE TO EAST.

C. Description of monument for corner and accessories established to perpetuate locating the position of the corner:

K-1 T2S R2W  
4 INCH DIAMETER BY 36" LONG CONCRETE MONUMENT WITH ALUMINUM CAP LS STAMPED 28409  
094° NAZ STANDARD MONUMENT 19.14' (K-13 T1S R2W TOMPKINS TOWNSHIP)  
129° NAZ 6" CHERRY 20.83' NAIL AND TAG IN SW SIDE  
167° NAZ 9" HICKORY 30.36' NAIL & SHINER IN EAST SIDE  
185° NAZ 2.00' SURVEY MARKER SIGN POST  
190° NAZ 8" CHERRY 28.57' 60D SPIKE IN EAST SIDE  
353° NAZ 4" HICKORY 14.36' NAIL & TAG IN EAST SIDE  
NOTE: NAIL & TAGS ARE 20D SPIKES AND ALUMINUM TAGS STAMPED PS 28409  
NOTE: NAZ IS MAGNETIC AZIMUTH MEASURED FROM NORTH.

Signed by Ronald L. Enger Date DECEMBER 21, 1996

Surveyor's Michigan License No. 28409

<sup>2</sup>  
K-1 T~~S~~W R2W  
PART A CONTINUED

2. RICHARD E. GUTEKUNST RLS 7863 CALLED FOR CORNER AS ONE OF HIS WITNESSES FOR K-13 T1S R2W IN A ACT 74 CERTIFICATE RECORDED IN LIBER 2 PAGE 353 IN OCTOBER 1972.  
"WEST - IRON (NWC SECTION 1 T2S, R2W) -- 19.14'

3. THIS SURVEYOR USED CORNER AS A WITNESS TO K-13 T1S R2W IN A ACT 345 CERTIFICATE RECORDED IN LIBER 1501 PAGE 1065 IN DECEMBER 1994.  
" 270° NAZ K-1, T2S R2W 19.14' ½" PIPE"