

JACKSON COUNTY
LOVED LAND CORNER
P.A. 343 of 1980

NORTH 1/4 CORNER SECTION 1
SANDSTONE TOWNSHIP

Surveyor Ronald L. Enger
Date Nov. 26, 1996

LAND CORNER RECORDATION CERTIFICATE
Filing Requirement of Act 74, Mich. P.A. 1970

For corners in
JACKSON
(County)

Located In: Corner Code #

1. Public Land Survey	T	2S	R	2W	L-1
	T		R		
	T		R		
	T		R		
2. Property Controlling in Section	S		T	R	
	S		T	R	
3. Miscellaneous Property in Sec.	S		T	R	
	S		T	R	

#2023468
Liber 1534 Page 1
Page 1 of 1
Jackson Co., MI
Recorded
12/26/96 11:12A
Jerry McDevitt
Register of Deeds

Register of Deeds Stamp & File Number

4. Lot No. _____, Recorded Plat _____
5. Private Claims _____


A	B	C	D	E	F	G	H	I	J	K	L	M
2	6	5	4	3	2							
3												
4	7	8	9	10	11	12						
5												
6	18	17	16	15	14	13						
7												
8	19	20	21	22	23	24						
9												
10	30	29	28	27	26	25						
11												
12	31	32	33	34	35	36						
13												

I, RONALD L. ENGER, in a field survey on NOVEMBER 18, 1996, do hereby certify that under requirements of P.A. 74, Michigan P.A. of 1970, the corner points mentioned in lines 1 and 2 above were in conformance with regulations and rules therefore as required in the current manual of survey instructions of the United States Department of the Interior, Bureau of Land Management or by a decree of a Court of Law and/or that the corner points mentioned in lines 3, 4 and 5 above were in conformance with the rules of the Michigan Board of Land Surveyors or by a Decree of a Court of Law; established, re-established, monumented, re-monumented, recovered, found as expressed below:

NOTE: Not more than 4 corners, all in the same town and range, may be recorded on this certificate.

A. Description of original monument and accessories and/or subsequent restoration:

1. POST NOT SET IN ORIGINAL GOVERNMENT SURVEY

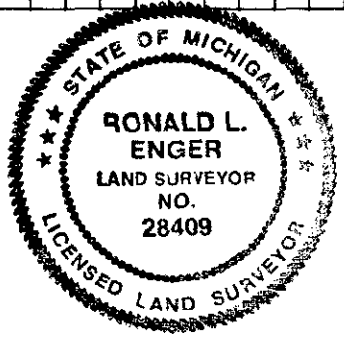

B. Description of corner evidence found and/or method applied in restoring or reestablishing corner:

SEARCHED AT APPARENT LOCATION OF CORNER AND FOUND NO EVIDENCE OF CORNER. SET STANDARD MONUMENT ON STANDARD LINE AND MIDWAY BETWEEN K-1 AND M-1 T2S R2W. CORNER FALLS ON FENCE LINE TO SOUTH AND ON OCCUPATION LINE TO EAST.

C. Description of monument for corner and accessories established to perpetuate locating the position of the corner:

- L-1 T2S R2W
- 4 INCH DIAMETER BY 36" LONG CONCRETE MONUMENT WITH ALUMINUM CAP LS 28409
- 026° NAZ 18" SASSAFRAS 20.07' NAIL & TAG IN EAST SIDE
- 090° NAZ STANDARD MONUMENT 6.79' (L-13 T1S R2W TOMPKINS TOWNSHIP)
- 091° NAZ 8" HICKORY 90.01' NAIL AND TAG IN NORTH SIDE
- 162° NAZ 17" SASSAFRAS 16.93' NAIL & TAG IN WEST SIDE
- 266° NAZ 4" WOOD FENCE POST 2.77' NAIL & TAG IN SOUTH SIDE
- 270° NAZ SURVEY SIGN POST 1.0'

NOTE: NAIL & TAGS ARE 20D SPIKES AND YELLOW PLASTIC TAGS STAMPED PS 25837
NOTE: NAZ IS MAGNETIC AZIMUTH MEASURED FROM NORTH.

Signed by Ronald L. Enger Date NOVEMBER 23, 1996

Surveyor's Michigan License No. 28409