

JACKSON COUNTY
 APPROVED LAND CORNER
 P.A. 345 of 1990

Chairman Dean R. Ballantyne
 Date Dec. 20, 1994

NORTHEAST CORNER SECTION 1 LIBER 1466 PAGE 29
 SANDSTONE TOWNSHIP
 LAND CORNER RECORDATION CERTIFICATE
 Filing Requirement of Act 74, Mich. P.A. 1970

JACKSON
 (County)

Located In:

Corner Code # SURVEY &
 REMONUMENTATION

STATE OF MICHIGAN
 JACKSON COUNTY
 RECORDED

1. Public Land Survey

T 2S R 2W

M-1

MAY 17 1995

2 MAY 95 8:26 A.M.

2. Property Controlling
 in Section

S T R
 S T R

COMMISSION

GERALD J. McDEVITT
 REGISTER OF DEEDS


3. Miscellaneous
 Property in Sec.

S T R
 S T R

Register of Deeds Stamp & File Number

4. Lot No. _____, Recorded Plat _____

5. Private Claims _____

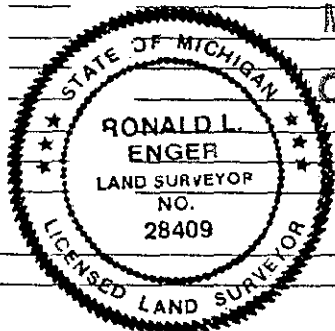

	A	B	C	D	E	F	G	H	I	J	K	L	M
2	6		5		4		3		2		1		
3													
4	7		8		9		10		11		12		
5													
6	13		17		16		15		14		13		
7													
8	19		20		21		22		23		24		
9													
10	30		29		28		27		26		25		
11													
12	31		32		33		34		35		36		
13													

I, RONALD L. ENGER in a field survey on OCTOBER 7, 19 94, do hereby certify that under requirements of P.A. 74, Michigan P.A. of 1970, the corner points mentioned in lines 1 and 2 above were in conformance with regulations and rules therefore as required in the current manual of survey instructions of the United States Department of the Interior, Bureau of Land Management or by a decree of a Court of Law and/or that the corner points mentioned in lines 3, 4 and 5 above were in conformance with the rules of the Michigan Board of Land Surveyors or by a Decree of a Court of Law; established, re-established, monumented, re-monumented, recovered, found as expressed below:

NOTE: Not more than 4 corners, all in the same town and range, may be recorded on this certificate.

A. Description of original monument and accessories and/or subsequent restoration:

- GLO DATE UNCERTAIN, FROM GLO NOTES FOR TOMPKINS: ASH 18 S67E 5-1/2 AND DO 7 N79-1/2W 24.
- BETWEEN MAY AND JULY OF 1885, H.F. BEAN REPORTED "FOUND POST AND REMAINS OF SIGHT TREE 214 LINKS NORTH" AND RECORDED TWO WITNESSES: HICKORY 6 N74W 32-1/2 (21.4') AND ELM 5 N53E 66 (43.6').

CONTINUED ON BACK

B. Description of corner evidence found and/or method applied in restoring or reestablishing corner:

SEARCHED AT APPARENT LOCATION OF CORNER AND FOUND 3/4" PIPE WITH CAP RLS 7863 IN MONUMENT BOX 2.5' EAST OF THE CENTERLINE OF BLACKMAN ROAD AND ON OCCUPATION LINE WEST. PULLED PIPE AND DUG THROUGH BOTTOM OF MONUMENT BOX AND FOUND FIRECLAY POST WITH "T" IRON ON NORTH SIDE OF IT. FIRECLAY IS 2' DEEP AND UNDER THE SOUTH EDGE OF MONUMENT BOX. COULD NOT DRILL OR MOVE THE FIRECLAY POST. SET 5/8" REBAR WITH JACKSON COUNTY REMONUMENTATION CAP ON NORTH SIDE OF THE FIRECLAY AND ON EAST SIDE OF THE "T" IRON (WHICH IS REAL CLOSE TO THE POSITION PREVIOUSLY OCCUPIED BY THE 3/4" PIPE AND CAP) AND CALLED IT CLOSE ENOUGH TO THE CORNER POSITION.

\$ 2.00 REMONUMENTATION
 \$ 9.00 CORNER REMONUMENTATION

C. Description of monument for corner and accessories established to perpetuate locating the position of the corner:

M-1 T2S R2W			
5/8 INCH DIAMETER BY 24 INCH LONG REBAR AND ALUMINUM CAP LS 28409 IN MONUMENT BOX			
141° NAZ 26" OAK	25.15'	NAIL AND TAG {NO #}	IN SOUTHWEST SIDE
160° NAZ 19" OAK	41.00'	NAIL AND TAG {NO #}	IN SOUTHWEST SIDE
180° NAZ FIRECLAY POST	0.15'	CENTER OF CROSS	IN TOP
220° NAZ 12" OAK	42.28'	NAIL AND TAG {NO #}	IN SOUTHEAST SIDE
269° NAZ 13" OAK	27.36'	NAIL AND TAG {NO #}	IN NORTH SIDE
338° NAZ 5" HICKORY	70.70'	NAIL & TAG LS 28409	IN NORTHEAST SIDE

NOTE: NAZ IS MAGNETIC AZIMUTH MEASURED FROM NORTH.

Signed by Ronald L. Enger Date DECEMBER 19, 1994
 Surveyor's Michigan License No. 28409

M-1 T2S R2W
PART A CONTINUED

3. ON OCTOBER 27, 1885, JOHN HOLCROFT REPORTED "FOUND POST AT CORNER SET BY H.F. BEAN FOR RIVES. THIS CORNER HAD BEEN KEPT UP AND AGREES WITH REMAINS OF OLD LINE 214 LKS NORTH" AND SHOWS SAME WITNESSES AS BEAN (ITEM 2).

4. CORNER IS COMMON TO NORTHEAST OF SECTION 1, T2S, R2W. ACT 74 LAND CORNER RECORDATION CERTIFICATE (LIBER 3 PAGE 250) FILED BY RONALD W. KELLER, LS 20707 ON APRIL 17, 1980 STATES THAT IN MARCH 1980 HE FOUND A "T-IRON CENTERLINE GRAVEL AND INLINE WITH FENCE TO WEST". THREE WITNESSES ARE SHOWN: S45°E, 24" OAK, 25.10'; S45°W, 6" OAK, 42.45' AND S88°W, 8" OAK, 27.45'.

5. ACT 74 LAND CORNER RECORDATION CERTIFICATE (LIBER 4 PAGE 294) FILED BY ALAN SCHEPPELMAN, LS 35998 ON OCTOBER 24, 1994 STATES THAT JUNE 11, 1994 HE FOUND A "3/4 INCH PIPE (CAP #7863) IN MON. BOX". FOUR WITNESSES ARE SHOWN: 20D NAIL & TAG IN NORTH SIDE 14" OAK, S80°W, 27.38; 20D NAIL & TAG IN EAST SIDE 12" OAK, S45°W, 42.38'; 20D NAIL & TAG IN SE SIDE 16" OAK, S20°E, 41.00' AND 20D NAIL & TAG IN SE SIDE 18" OAK, S40°E, 25.15'.