Date Rec'd 20 of 19

Checkman Dean L. Gallemore

Date August 11, 1999

NORTHWEST CORNER SECTION 6
PARMA TOWNSHIP
LAND CORNER RECORDATION CERTIFICATE
Filing Requirement of Act 74, Mich. P.A. 1970

SURVEY & REMONUMENTATION

MAR 1 3 2000

SECTION

For corners in

JACKSON (County) Located In: Corner Code #

1. Public Land Survey T 2S R 3W A-1
   T___ R___
   T___ R___
   T___ R___
2. Property Controlling in Section S___ T___ R___
   S___ T___ R___
3. Miscellaneous Property in Sec. S___ T___ R___
   S___ T___ R___

Mindy Reilly - Jackson Co. CORREM

2138087
Page: 1 of 1
11/24/1999 02:42P
L-1618 P-26

Register of Deeds Stamp & File Number

4. Lot No. _____, Recorded Plat _____
5. Private Claims _____

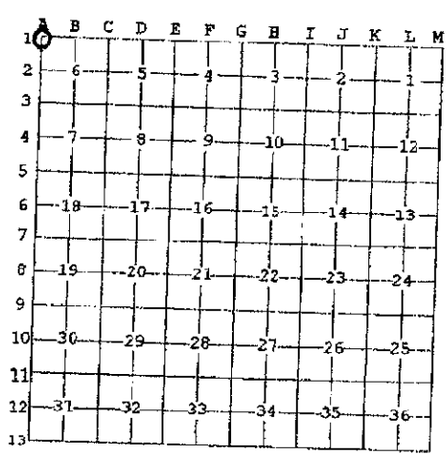

I, DAVID L. CLIFFORD, in a field survey on JANUARY 14, 1998 do hereby state that under requirements of P.A. 74, Michigan P.A. of 1970, the corner points mentioned in lines 1 and 2 above were in conformance with regulations and rules therefore as required in the current manual of survey instructions of the United States Department of the Interior, Bureau of Land Management or by a decree of a Court of Law and /or that the corner points mentioned in lines 3, 4 and 5 above were in conformance with the rules of the Michigan Board of Land Surveyors or by a Decree of a Court of Law; established, re-established, monumented, recovered, found as expressed below:

NOTE: Not more than 2 corners, all in the same town and range, may be recorded on this certificate.

A. Description of original monument and accessories and/or subsequent restoration:
1. ORIGINAL POST SET BY JOSEPH WAMPLER D.S. IN JAN. 1824: B.O., 13", N46W, 42; W.O. 14" S34W, 73.

2. IN FEB. 1889 JAMES GIFFORD REPORTED: "TOWN CORNER-FOUND STUMP OF GOVERNMENT BEARING TREE, SET POST(2½" CLAY TILE) AT ANGLE ROAD: HICK., 6", N62¼E, 118LKS(77.9'); ASPEN, 6", N34E, 48(31.7')

3. DON DAVIS RLS #17617 IDENTIFIED CORNER AS AN IRON PIPE IN MAY 1976: 24" OAK, N5°E, 34.4'; 18" HICK., N62°E, 77.9'*, 24" OAK, NW, 27.72'*(IN DAVIS'S NOTES THE CORNERS MARKED * WERE NOTED AS ORIGINAL)

B. Description of corner evidence found and/or method applied in restoring or reestablishing corner:
SEARCHED AT APPARENT LOCATION OF CORNER AND FOUND 3/4" IRON PIPE MATCHING DAVIS'S WITNESSES (HICK. WITNESS TO NE IS NOW A STUMP), 10' WEST OF CENTERLINE CALHOUN ROAD TO SOUTH AND 6' SOUTH OF FENCE TO WEST. EXCAVATED 2' DIAMETER HOLE 4' DEEP INTO NATURAL GOUND AND FOUND PICK HEAD UNDER 3/4" X 18" PIPE AND 3/4" X 10" PIPE UNDER PICKHEAD. DID NOT ACCEPT PIPE AS CORNER BECAUSE OF INABILITY TO FIND TILE AND LACK OF AGREEMENT WITH OCCUPATION. EXCAVATED 6' X 6' X 5' DEEP HOLE WITH A BACKHOE. EXCAVATION WAS CENTERED ON FENCE TO WEST AND 78' FROM HICK. STUMP TO NE. AT A DEPTH OF 5' FOUND 2½" SOLID CLAY TILE IN A 2½" CLAY DRAIN TILE STANDING VERTICALLY IN NATURAL SOIL. TILE MEASURED N67°E, 78.1' TO HICKORY STUMP TO NE (GIFFORD'S WITNESS). THE TOP 5" OF TILE WAS BROKEN OFF DURING EXCAVATION. ACCEPTED TILE AS CORNER AS PERPETUATED BY GIFFORD IN 1889 AND SET A 5/8" BAR AND CAP #28409 ABOVE IT. CORNER LIES 3' WEST OF EAST EDGE CALHOUN ROAD TO SOUTH AND ON SOUTH EDGE OF ELMER ROAD TO EAST AND 1.5' NORTH OF FENCE LINE TO WEST. ON MARCH 15, 1999 REPLACED BAR & CAP WITH HARRISON MONUMENT.

C. Description of monument for corner and accessories established to perpetuate locating the position of the corner:
A-1 T2S R3W
4" X 30" CAST IRON HARRISON MONUMENT AND BRASS CAP STAMPED 25837
NAIL & TAG 28409 EAST SIDE 36" OAK, N25°W, 15.31'
NAIL & TAG 28409 WEST SIDE 34" OAK, N30°E, 28.58"
NAIL & TAG 28409 SOUTH SIDE 14" OAK, N60°E, 45.66'
NAIL & TAG 28409 SE SIDE 6" HICKORY, N45°E, 30.65'
NAIL & TAG 28409 EAST SIDE 19" HICKORY, S25°W, 53.72'
3/4" IRON PIPE, S35°E, 10.68'
SURVEY MARKER SIGN POST, WEST, 1.0'

STATE OF MICHIGAN
DAVID L. CLIFFORD
LAND SURVEYOR
NO. 25837
REGISTERED LAND SURVEYOR

Signed by David Clifford Date MARCH 16, 1999

Surveyor's Michigan License No. 25837

FORM APPROVED BY MICHIGAN STATE BOARD OF PROFESSIONAL SURVEYORS, JAN. 21, 1971
REVISED MAY 14, 1975
REVISED JAN., 1983
REVISED OCT., 1985