

JACKSON COUNTY
 APPROVED LAND CORNER
 P.A. 345 of 1990
 ACTING
 Chairman
 Timothy E. Van...
 Date MARCH 12, 1997

WEST 1/4 POST, SECTION 13
 PARMA TOWNSHIP

LAND CORNER RECORDATION CERTIFICATE
 Filing Requirement of Act 74, Mich. P.A. 1970

#2029642
 Liber 1538 Page 538
 Page 1 of 2
 Jackson Co., MI
 Recorded
 03/13/97 03:41P
 Mindy Reilly
 Register of Deeds

For corners in
JACKSON
 (County)

Located In: Corner Code #

1. Public Land Survey T 2 S R3 W K-6 SURVEY & REMONUMENTATION
 T ___ R ___
 T ___ R ___
 T ___ R ___
 2. Property Controlling S ___ T ___ R ___
 in Section S ___ T ___ R ___
 3. Miscellaneous S ___ T ___ R ___
 Property in Sec. S ___ T ___ R ___

APR 07 1998

SECTION Register of Deeds Stamp & File Number

4. Lot No. _____, Recorded Plat _____
 5. Private Claims _____

| A | B | C | D | E | F | G | H | I | J | K | L | I |
|----|----|----|----|----|----|----|---|---|---|---|---|---|
| 2 | 6 | 5 | 4 | 3 | 2 | 1 | | | | | | |
| 3 | | | | | | | | | | | | |
| 4 | 7 | 8 | 9 | 10 | 11 | 12 | | | | | | |
| 5 | | | | | | | | | | | | |
| 6 | 18 | 17 | 16 | 15 | 14 | 13 | | | | | | |
| 7 | | | | | | | | | | | | |
| 8 | 19 | 20 | 21 | 22 | 23 | 24 | | | | | | |
| 9 | | | | | | | | | | | | |
| 10 | 30 | 29 | 28 | 27 | 26 | 25 | | | | | | |
| 11 | | | | | | | | | | | | |
| 12 | 31 | 32 | 33 | 34 | 35 | 36 | | | | | | |
| 13 | | | | | | | | | | | | |

I, Dean R. Gutekunst, in a field survey on 6/27/96 & 7/18 19 96
 do hereby certify that under requirements of P.A. 74, Michigan P.A. of 1970, the corner points mentioned
 in lines 1 and 2 above were in conformance with regulations and rules therefore as required in the
 current manual of survey instructions of the United States Department of the Interior, Bureau of Land
 Management or by a decree of a Court of Law and/or that the corner points mentioned in lines 3, 4 and 5
 above were in conformance with the rules of the Michigan Board of Land Surveyors or by a Decree of a
 Court of Law, established, re-established, monumented, re-monumented, recovered, found as
 expressed below:

NOTE: Not more than 4 corners, all in the same town and range, may be recorded
 on this certificate.

A. Description of original monument and accessories and/or subsequent restoration:

Original Government Post set by Lucius Lyon, Deputy Surveyor, April 1825.
 W. Oak 34" N 37 W 64 links (42.24')
 B. Oak 24" S 50 1/2 E 160 links (105.60')

No perpetuation found for the 1880's.

Perpetuation by Richard E. Gutekunst, RLS # 7863, dated 1967 and 4/29/76.
 Found iron in center line Miner and Brown Roads, 1967, and iron in box in 1976.

Continued on back,


B. Description of corner evidence found and/or method applied in restoring or reestablishing corner:

Found iron in monument box to surface of blacktop, Miner Road.
 Backhoe excavation of a 5' North & South by 8' East & West and 5' deep area did not
 reveal any additional evidence of the original corner.
 Accepted the surface iron found as the only perpetuation of the original corner.
 Set a Standard Jackson County Monument to replace the iron and buried iron beside monument.

C. Description of monument for corner and accessories established to perpetuate locating the position of the corner:

K-6 T2S, R3W Corner is a 4" diameter X 36" concrete monument with a 1/2" X 36"
 steel rod and an aluminum cap stamped LS 18658, which is the
 standard monument for Jackson County.

N 50° E 49" Oak 192.59' 40d & washer on West side.
 N 70° E 34" Oak 161.04' 40d & washer on North side.
 *** S 45° E 32" Pine 97.08' 40d & washer on Northeast side.
 S 50° W 2" Hickory 53.20' center line of tree, no nail
 * N 70° W 24" Hickory 133.46' 40d & washer on South side.
 N 30° W 17" Maple 77.62' 40d & washer on West side.
 N 40° W Angle iron corner post 46.92'
 Monument box set over monument by Jackson County Road Commission.

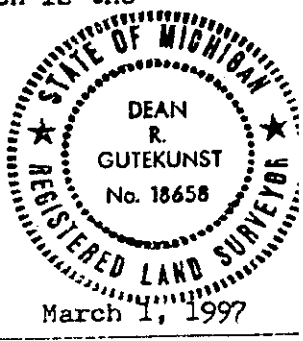

Signed by Dean R. Gutekunst Date _____
 Surveyor's Michigan License No. 18658

Continued,

K-6 T2S, R3W

A.

| | | | | |
|-----|-----------|-----------------------------------|---------|-----------|
| * | N 78 W | 14" Hickory | 133.33' | |
| | N 57 E | 30" Oak | 61.42' | gone 1976 |
| ** | N 71 E | 30" Oak | 105.55' | |
| | S 63 E | 20" Pine | 97.30' | |
| *** | S 43 E | 20" Pine | 96.28' | |
| | S 23 E | 20" Pine | 99.85' | gone 1976 |
| | S 80 E | 15" Twin Cedar | 129.7' | |
| | S 45 30 E | Northwest corner of house # 11963 | | 155.73' |

- P A. 74, recorded by Richard E. Gutekunst, RLS # 7863, dated November 22, 1976, in LCRC, Liber 3, Page 51, Jackson County Records.

Same information as above in 1976.

- P.A. 74, recorded by Ronald W. Keller, RLS # 20707, dated December 6, 1979, in LCRC, Liber 3, Page 231, Jackson County Records.

Found iron in monument box

| | | | |
|-----|--------|-------------|---------|
| * | N 78 W | 14" Hickory | 133.33' |
| ** | N 71 E | 30" Oak | 105.55' |
| *** | S 63 E | 20" Pine | 97.30' |
| | S 80 W | 15" T-Cedar | 129.70' |