

**JACKSON COUNTY
APPROVED LAND CORNER
P.A. 343 of 1990**

Chairman Dean R. Hattamal
Date Dec 8, 1999

**EAST 1/4 CORNER SECTION 20
NAPOLEON TOWNSHIP
LAND CORNER RECORDATION CERTIFICATE
Filing Requirement of Act 74, Mich. P.A. 1970**


**SURVEY &
REMONUMENTATION**

MAR 1 8 2000

For corners in

JACKSON Located In: _____ Corner Code # _____
(County)

- 1. Public Land Survey T 3S R 1E E-8
T _____ R _____
T _____ R _____
T _____ R _____
- 2. Property Controlling S _____ T _____
in Section S _____ T _____
- 3. Miscellaneous S _____ T _____
Property in Sec. S _____ T _____

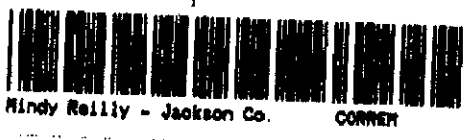

2139393
Page: 1 of 1
12/08/1999 12:27P
L-1618 P-1245

Register of Deeds Stamp & File Number

SECTION

- 4. Lot No. _____, Recorded Plat _____
- 5. Private Claims _____

I, DAVID L. CLIFFORD, in a field survey on JUNE 10, 1996 do hereby state that under requirements of P.A. 74, Michigan P.A. of 1970, the corner points mentioned in lines 1 and 2 above were in conformance with regulations and rules therefore as required in the current manual of survey instructions of the United States Department of the Interior, Bureau of Land Management or by a decree of a Court of Law and for that the corner points mentioned in lines 3, 4 and 5 above were in conformance with the rules of the Michigan Board of Land Surveyors or by a Decree of a Court of Law, established, re-established, monumented, recovered, found as expressed below.

NOTE: Not more than 2 corners, all in the same town and range, may be recorded on this certificate.

	A	B	C	D	E	F	G	H	I	J	K	L	M
1													
2		6	5	4	3	2	1						
3													
4		7	8	9	10	11	12						
5													
6		10	17	16	15	14	13						
7													
8		19	20	21	22	23	24						
9													
10		30	29	28	27	26	25						
11													
12		31	32	33	34	35	36						
13													

A. Description of original monument and accessories and/or subsequent restoration:

1. ORIGINAL POST SET BY HERVEY PARKE D.S. IN FEBRUARY 1825: B.O., 19', S35W, 75; B.O. 14" S37E 98.
2. IN 1886, H.F. BEAN REPORTED "FOUND STAKE AT CORNER AGREEING WITH STUMP OF FIRST GOVT. WITNESS, SET POST IN DITCH": W. OAK 20", S1W, 69 LKS(45.5); Y. OAK, 15", S88½E, 34½ LKS (225.4')
3. IN NOVEMBER 1961, RON KELLER, LS 20707, USED CORNER IN A SURVEY RECORDED IN LIBER 1016 PAGE 451 OF SURVEYS. HE FOUND A 3/4" PIPE & TOOK THE FOLLOWING WITNESSES: NAIL W. FACE 42" OAK, SOUTH, 45.95'; NAIL E. FACE 16" ELM, NORTH, 38.30'; NAIL W. FACE 10" CHERRY, SOUTHERLY, 59.53'.

B. Description of corner evidence found and/or method applied in restoring or reestablishing corner:

SEARCHED AT APPARENT LOCATION OF CORNER AND FOUND 3/4" PIPE IN SWAMP. FOUND FIRE CLAY IN GOOD CONDITION ON WEST SIDE OF PIPE UNDER WATER. KELLERS OAK WITNESS TO THE SOUTH IS BEANS W. OAK WITNESS AND IS STILL STANDING. FOUND REMAINS OF BEANS Y. OAK WITNESS TO THE EAST WHICH IS DEAD AND LYING ON GROUND. ACCEPTED FIRECLAY AS CORNER AS PERPETUATED BY BEAN IN 1886. SET STANDARD JACKSON COUNTY ALUMINUM PIPE MONUMENT IN PLACE OF FIRECLAY. LEFT FIRE CLAY BURIED ON WEST SIDE. LEFT PIPE BURIED ON EAST SIDE.

C. Description of monument for corner and accessories established to perpetuate locating the position of the corner:

E-8 T3S R1E
3/4" X 60" ALUMINUM PIPE MONUMENT WITH 3" ALUMINUM CAP STAMPED 25837
60 D SPIKE IN WEST SIDE 42" WHITE OAK, SOUTH, 45.95' (BEAN WITNESS)
60 D SPIKE IN WEST SIDE 14" CHERRY, SOUTH, 59.58'
NAIL & TAG 28409 EAST SIDE 16" ELM, N3°E, 38.30'
NAIL & TAG 28409 NW SIDE 12" CHERRY, S41°W, 46.48'
SURVEY MARKER SIGN POST, NORTH, 1.0'



Signed by David L. Clifford

Date DECEMBER 06, 1999

Surveyor's Michigan License No. 25837