

**JACKSON COUNTY
APPROVED LAND CORNER
P.A. 345 of 1990**

SOUTHEAST CORNER, SECTION 34
NAPOLEON TOWNSHIP

LIBER 1482 PAGE 622

Acting Chairman Dean R. Gutekunst Ron Enger

LAND CORNER RECORDATION CERTIFICATE

Date 12-30-94
For corners in

Filing Requirement of Act 74, Mich. P.A. 1970

STATE OF MICHIGAN
JACKSON COUNTY
RECORDED

17 AUG 95 9:47 A.M.

GERALD J. McDEVITT
REGISTER OF DEEDS

Register of Deeds Stamp & File Number

JACKSON (County) Located In: Corner Code #

1. Public Land Survey	T <u>3</u> S R <u>1</u> E	<u>I-13</u>
	T _____ R _____	_____
	T _____ R _____	_____
	T _____ R _____	_____
2. Property Controlling in Section	S _____ T _____ R _____	_____
	S _____ T _____ R _____	_____
3. Miscellaneous Property in Sec.	S _____ T _____ R _____	_____
	S _____ T _____ R _____	_____

4. Lot No. _____, Recorded Plat _____

5. Private Claims _____

	A	B	C	D	E	F	G	H	I	J	K	L	M
2	6	5	4	3	2	1							
3													
4	7	8	9	10	11	12							
5													
6	18	17	16	15	14	13							
7													
8	19	20	21	22	23	24							
9													
10	30	29	28	27	26	25							
11													
12	31	32	33	34	35	36							
13													

I, DEAN R. GUTEKUNST, in a field survey on August 5, 19 94, do hereby certify that under requirements of P.A. 74, Michigan P.A. of 1970, the corner points mentioned in lines 1 and 2 above were in conformance with regulations and rules therefore as required in the current manual of survey instructions of the United States Department of the Interior, Bureau of Land Management or by a decree of a Court of Law and/or that the corner points mentioned in lines 3, 4 and 5 above were in conformance with the rules of the Michigan Board of Land Surveyors or by a Decree of a Court of Law; established, re-established, monumented, re-monumented, recovered, found as expressed below:

NOTE: Not more than 4 corners, all in the same town and range, may be recorded on this certificate.

A. Description of original monument and accessories and/or subsequent restoration:


Original Government Post set by Benjamin Hough, Deputy Surveyor, 1815
 B. Oak 24" North 14 links (9.24')
 Hickory 12" S 31 1/2 W 30 links (19.80')
 Perpetuation by H. F. Bean, date unknown
 White Oak 10" S 41 W 52 links (34.32')
 White Oak 30" N 23 E 36 3/4 links (24.26')

Continued on back,

B. Description of corner evidence found and/or method applied in restoring or reestablishing corner:

Found STONE, and iron pipe, 11.22' East of Northwest corner of Section 2, Town 4 South, Range 1 East. Approximately on center line of blacktop of Stony Lake Road. Stone was broken in excavation for monument.

Accepted STONE as a careful and faithful perpetuation of the position of the original corner, as re-monumented by Bean and Holcroft. Replaced stone with a Standard Jackson County Monument and left the broken stone pieces around the monument.

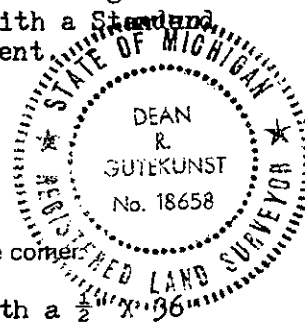

C. Description of monument for corner and accessories established to perpetuate locating the position of the corner:

I-13 T3S, R1E Corner is a 4" diameter X 36" concrete monument with a 1/2" X 3/8" steel rod and an aluminum cap stamped LS 18658, which is the standard monument for Jackson County.

- (*) S 50° W 32" Oak 27.10' 40d & washer on West side
- S 75° W 28" Hickory 94.64' 40d & washer on Northwest side
- S 15° E 26" Oak 28.35' 40d & washer on West side
- N 55° E 6" Oak 44.99' 40d & washer on Northwest side
- S 65° E 21" Hickory (south of two) 74.20' 40d & washer on Southwest side

Monument box set over monument by Jackson County Road Commission

Signed by Dean R. Gutekunst Date December 29, 1994

Surveyor's Michigan License No. 18658

A. Continued,

Perpetuation by John Holcroft, date unknown

Hickory 8"	N 69 $\frac{1}{4}$ E	109 $\frac{1}{2}$ links (72.27')
Hickory 9"	N 15 E	106 $\frac{3}{4}$ links (70.46')

Found long permanent stone
at corner by H. F. Bean. Left
stone at corner.

Perpetuation by F. C. Riley, #377, dated 1929

Hickory 10"	North	46.0'
(*) W. Oak 16"	S 3 W	26.85'
1' East of fence North		

Found stone.

Perpetuation by Richard E. Gutekunst, # 7863, dated January 22, 1969.

Found stone, at corner, 11.22' East of the Northwest corner of Section 2,
Town 4 South, Range 1 East (iron in monument box.

Set iron pipe to surface

(*) Southerly	30" Oak	27.20'
Southeasterly	18" Hickory	74.20'
Southwesterly	20" Hickory	94.64'