

Chairman Alan R. Galt

Date Oct. 30, 1995

LAND CORNER RECORDATION CERTIFICATE
Filing Requirement of Act 74, Mich. P.A. 1970

STATE OF MICHIGAN
JACKSON COUNTY
RECORDED

For corners in
Jackson County
(County)

Located In:

Corner Code #

27 DEC 95 10:15 A.M.

- | | | | | | |
|---|---|------|---|------|------------------------|
| 1. Public Land Survey | T | 3 S, | R | 1 W, | I-11 |
| | T | | R | | |
| | T | | R | | |
| | T | | R | | |
| | | | | | REMONUMENTATION |
| 2. Property Controlling
in Section | S | | T | R | |
| | S | | T | R | FEB 22 1996 |
| 3. Miscellaneous
Property in Section | S | | T | R | |
| | S | | T | R | COMMISSION |

GERALD J. McDEVITT
REGISTER OF DEEDS

Register of Deeds Stamp & File Number

4. Lot No. _____, Recorded Plat _____
5. Private Claims _____

Timothy B. Van Gieson, in a field survey on February 15, 1995, do hereby certify that under requirements of P.A. 74, Michigan P.A. of 1970, the corner points mentioned in lines 1 and 2 above were in conformance with regulations and rules therefore as required in the current manual of survey instructions of the United States Department of the Interior, Bureau of Land Management or by a decree of a Court of Law and/or that the corner points mentioned in lines 3, 4 and 5 above were in conformance with the rules of the Michigan Board of Professional Surveyors or by a Decree of a Court of Law; established, re-established, monumented, re-monumented, recovered, found as expressed below:

NOTE: Not more than 4 corners, all in the same town and range, may be recorded on this certificate.

	A	B	C	D	E	F	G	H	I	J	K	L	M
2	6		5		4		3		2		1		
3													
4	7		8		9		10		11		12		
5													
6	18		17		16		15		14		13		
7													
8	19		20		21		22		23		24		
9													
10	30		29		28		27		26		25		
11													
12	31		32		33		34		35		36		
13													

A. Description of original monument and accessories and/or subsequent restoration:

- 11: Original government survey dated: February 13, 1825
"Wood Post" "80.00 ch. (5,280.00') set post corner Sections 26, 27, 34, 35."
Elm 16" South 17-1/2 links (11.55')
Cedar 12" N 6-1/2° E 40 links (26.40')
Hervey Parke (Deputy Surveyor)
May 04, 1825
- 11: Remonumentation survey dated: 1886 (1866?)
"Fire Clay" "Post and witness standing."
Elm 10" S 37° W 48 links (31.68')
Swamp Oak 4" S 28-1/2° E 11 links (7.26')
H.F. Bean
(No specific date recorded)
- 11: No P.A. 74 recordings (see back for unrecorded supporting documentation)

B. Description of corner evidence found and/or method applied in restoring or reestablishing corner:

- 11: Found bottom 17" fire clay April of 1982.
Accepted fire clay as faithful and careful perpetuation of corner set in 1886.

Accessories used to verify corner location are as follows:

Maple 15" N 80° W 31.50'

Found this tree in April of 1982 and measured as: 60-d in 18" Maple N 80° W 31.86'
I believe this tree to be miss-labeled. Tree is actually a Swamp Oak.


Replaced fire clay with standard monument.

\$ 2.00 REMONUMENTATION
\$ 9.00 CORNER REMONUMENTATION

C. Description of monument for corner and accessories established to perpetuate locating the position of the corner:

- 11: 4" x 36" concrete monument with aluminum cap R.L.S. No. 24621

S 31° E	60-d in East side of 6" Ash	30.52'
S 64° W	60-d in South side of 13" Ash	66.80'
N 82° W	60-d in South side of 17" Swamp Oak	31.91'
N 32° W	60-d in South side of 18" Swamp Oak	4.15'

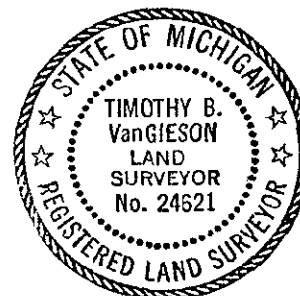

Timothy B. Van Gieson

Signed by Timothy B. Van Gieson

Date October 21, 1995

Surveyor's Michigan License No. 24621

I-11: Source: Kurzy Engineering
Date: Unknown

Maple 15" N 80° W 31.50'
Swamp Oak N 40° W 4.0'
Basswood S 45° W 48.75'

I-11: Source: Van Gieson Land Surveys
Date: April 1982

60-d in 20" Oak S 60° E 21.00
60-d in 24" Basswood S 45° W 49.18'
60-d in 18" Maple N 80° W 31.86'
60-d in 15" Oak N 40° W 4.11'
Fire clay

REMONUMENTATION
FEB 22 1996
COMMISSION