

Chairman TIMOTHY B VAN GIESEN  
 Date 02-12-97

LAND CORNER RECORDATION CERTIFICATE  
 Filing Requirement of Act 74, Mich. P.A. 1970

For corners in

JACKSON

(County)

Located In:

Corner Code #

1. Public Land Survey

T 3 S R 2 E

I-2

SURVEY &  
 REMONUMENTATION

#2028009  
 Liber 1537 Page 317  
 Page 1 of 1  
 Jackson Co., MI  
 Recorded  
 02/21/97 08:38A  
 Mindy Reilly  
 Register of Deeds

2. Property Controlling  
 in Section

S T R

APR 07 1998

SECTION


Register of Deeds Stamp & File Number

3. Miscellaneous  
 Property in Sec.

S T R

4. Lot No. \_\_\_\_\_, Recorded Plat \_\_\_\_\_

5. Private Claims \_\_\_\_\_

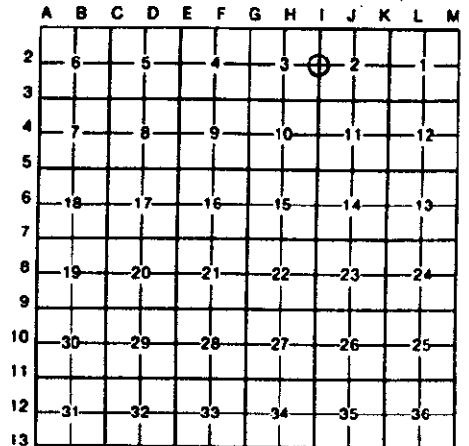

I, Dean R. Gutekunst, in a field survey on 7/27/94 & 11/21/95, 19\_\_\_\_\_, do hereby certify that under requirements of P.A. 74, Michigan P.A. of 1970, the corner points mentioned in lines 1 and 2 above were in conformance with regulations and rules therefore as required in the current manual of survey instructions of the United States Department of the Interior, Bureau of Land Management or by a decree of a Court of Law and/or that the corner points mentioned in lines 3, 4 and 5 above were in conformance with the rules of the Michigan Board of Land Surveyors or by a Decree of a Court of Law; established, re-established, monumented, re-monumented, recovered, found as expressed below:

NOTE: Not more than 4 corners, all in the same town and range, may be recorded on this certificate.

A. Description of original monument and accessories and/or subsequent restoration:

Original Government Post set by Hervey Parke, Deputy Surveyor, February 1824.  
 White Oak 36" N 41 E 53 links (34.98')  
 White Oak 18" S 76 1/2 W 240 links (158.40')

No perpetuation found for the 1880's.

Not recorded in P. A. 74



B. Description of corner evidence found and/or method applied in restoring or reestablishing corner:

Found small GRANITESTONE with two small stones and broken brick around, two foot below gravel surface of Barber Road.

Excavated with a backhoe to find stone, 7/27/1994.

Corner is 2.5' North of a fence East and 0.5' East of center line of blacktop.

Accepted the stone as a careful and faithful perpetuation of the position of the original corner.

Set a Standard Jackson County Monument to replace the stone and left stones and brick buried beside monument, 11/21/1995.

C. Description of monument for corner and accessories established to perpetuate locating the position of the corner:

I-2 T3S, R2E Corner is a 4" diameter X 36" concrete monument with a 1/2" X 36" steel rod and an aluminum cap stamped LS 18658, which is the standard monument for Jackson County.

S 85° E Northwest corner, top of Angle Iron corner post 25.52'

S 20° W 10" Maple 101.96' 40d & washer on East side

S 60° W 25" Maple 31.10' 40d & washer on Southeast side

N 30° W 27" Maple 40.20' 40d & washer set vertical in Southeast root

N 35° E 20" Maple 35.62' 40d & washer on West side

East Steel post and survey marker sign attached 30'

Monument box set over monument by Jackson County Road Commission.

Signed by Dean R. Gutekunst Date February 1, 1997

Surveyor's Michigan License No. 18658