

**JACKSON COUNTY
APPROVED LAND CORNER
P.A. 345 of 1990**

WEST 1/4 POST, SECTION 26
NORVELL TOWNSHIP

ACTING
Chairman Dean R. Gutekunst

LAND CORNER RECORDATION CERTIFICATE
Filing Requirement of Act 74, Mich. P.A. 1970

LIBER 1501 PAGE 1139

Date 12-27-1995
For corners in

JACKSON (County)	Located In:	Corner Code #
1. Public Land Survey	T <u>3 S</u> R <u>2 E</u>	<u>I-10</u>
	T _____ R _____	
	T _____ R _____	
	T _____ R _____	
2. Property Controlling in Section	S _____ T _____	SURVEY & REMONUMENTATION
	S _____ T _____	
3. Miscellaneous Property in Sec.	S _____ T _____	<u>SEP 30 1995</u>
	S _____ T _____	

STATE OF MICHIGAN
JACKSON COUNTY
RECORDED

29 DEC 95 11:21 A.M.

GERALD J. McDEVITT
REGISTER OF DEEDS

Register of Deeds Stamp & File Number

4. Lot No. _____, Recorded Plat SECTION
5. Private Claims _____

	A	B	C	D	E	F	G	H	I	J	K	L	M
2	6		5		4		3		2		1		
3													
4	7		8		9		10		11		12		
5													
6	18		17		16		15		14		13		
7													
8	19		20		21		22		23		24		
9													
10	30		29		28		27		26		25		
11													
12	31		32		33		34		35		36		
13													

I, DEAN R. GUTEKUNST, in a field survey on November 22, 19 95, do hereby certify that under requirements of P.A. 74, Michigan P.A. of 1970, the corner points mentioned in lines 1 and 2 above were in conformance with regulations and rules therefore as required in the current manual of survey instructions of the United States Department of the Interior, Bureau of Land Management or by a decree of a Court of Law and/or that the corner points mentioned in lines 3, 4 and 5 above were in conformance with the rules of the Michigan Board of Land Surveyors or by a Decree of a Court of Law; established, re-established, monumented, re-monumented, recovered, found as expressed below:

NOTE: Not more than 4 corners, all in the same town and range, may be recorded on this certificate.

A. Description of original monument and accessories and/or subsequent restoration:

Original Government Post set by Hervey Parke, Deputy Surveyor, February 1824.
 Y. Oak 22" S 30 W 3 links (1.98')
 Y. Oak 28" N 37 1/2 E 122 links (80.52')
 Perpetuation by B. F. LaRue, (1884 - 1885)
 Y. Oak 10" N 9 1/2 E 221 links (145.86') (stump 1925) Post standing and witnesses found.
 * Y. Oak 6" N 50 W 35 links (23.10')

(Fireclay 3" diameter X 24

\$ 2.00 REMONUMENTATION
\$ 9.00 CORNER REMONUMENTATION

B. Description of corner evidence found and/or method applied in restoring or reestablishing corner:


Found FIRECLAY, 18" below gravel surface, with broken brick around. Found capped iron rod # 30106 on top of fireclay.
 Corner is approximately 2' East of center line of Raby Road (gravel) running North & South. No occupation East or West, at road.
 Corner is between *pipelines, crossing road; * PANHANDLE EASTERN (NATURAL GAS)
 North Line of Green posts, either side of road 21.5'
 South Line of Yellow posts, either side of road 28.4'
 Accepted FIRECLAY, as a careful and faithful perpetuation of the position of the original corner, as remonumented by LaRue in (1884 - 1885). Set a Standard Jackson County Monument and left the fireclay on the South side, the capped rod on the Southeast side and the broken brick around monument.

C. Description of monument for corner and accessories established to perpetuate locating the position of the corner:

I-10 T3S, R2E Corner is a 4" diameter X 36" concrete monument with a 1/2" X 36" steel rod and an aluminum cap stamped LS 18658, which is the standard monument for Jackson County.

** S 10° E 49" Oak 88.20' Found a square nail in West side, and set an 8" timber spike over square nail.
 S 30° W 16" Oak 57.0' 40 d & washer on Southeast side
 N 20° W 10" Oak 65.23' 40d & washer on East side
 *** N 65° E Southwest face of Pipeline post (green) 27.05'
 N 35° W Southeast face of Pipeline post (green) 40.94'
 East Steel post with survey marker sign attached 22.0'

Signed by Dean R. Gutekunst Date December 22, 1995
 Surveyor's Michigan License No. 18658

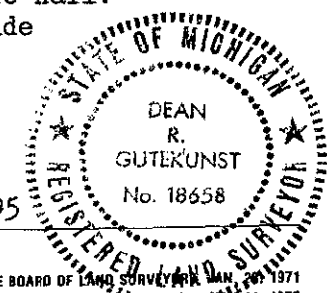

A. Continued,

- Perpetuation by Frank A. Fisher, # 3102, June 15, 1925
 - Fireclay post, 1' below surface
 - Red Oak 22" S 80 W 20.5'
 - ** Black Oak 20" S 10 E 87.50'

- Perpetuation by Fred C. Riley, # 377, 1936
 - Fireclay, just West of wheel track, and 9' South of fence East.
 - * Y. Oak 24" N 50 W 22.30'
 - Y. Oak 20" N 20 W 76.25'

- Perpetuation by Robert P. Wilkinson, IS # 30106 on survey dated 7/15/85
 - Found fireclay, set capped rod
 - ** S 10 E 46" Oak 88.75'
 - *** N 50 E Pipeline Post (Southwest face) 27.09'

- Not recorded in P. A. 74

SURVEY &
REMONUMENTATION

SEP 30 1998

SECTION