

NOV 03 1999

SOUTH 1/4 POST SECTION 26  
NORVELL TOWNSHIP

SECTION

JACKSON COUNTY  
APPROVED LAND CORNER  
P.A. 345 of 1990

ACTING Chairman Ren Enger

LAND CORNER RECORDATION CERTIFICATE  
Filing Requirement of Act 74, Mich. P.A. 1970

LIPER 1501 PAGE 1133

Date 12-27-1995

For corners in

JACKSON  
(County)

Located In:

Corner Code #

1. Public Land Survey	T <u>3</u> S R <u>2</u> E	J-11
	T _____ R _____	_____
	T _____ R _____	_____
	T _____ R _____	_____
2. Property Controlling in Section	S _____ T _____ R _____	_____
	S _____ T _____ R _____	_____
3. Miscellaneous Property in Sec.	S _____ T _____ R _____	_____
	S _____ T _____ R _____	_____

STATE OF MICHIGAN  
JACKSON COUNTY  
RECORDED

29 DEC 95 11:20 A.M.

GERALD J. McDEVITT  
REGISTER OF DEEDS

Register of Deeds Stamp & File Number

\$ 2.00 REMONUMENTATION

\$ 9.00 CORNER REMONUMENTATION

2	6	5	4	3	2	1
3						
4	7	8	9	10	11	12
5						
6	18	17	16	15	14	13
7						
8	19	20	21	22	23	24
9						
10	30	29	28	27	26	25
11					⊕	
12	31	32	33	34	35	36
13						

I, DEAN R. GUTEKUNST, in a field survey on November 22, 19 95, do hereby certify that under requirements of P.A. 74, Michigan P.A. of 1970, the corner points mentioned in lines 1 and 2 above were in conformance with regulations and rules therefore as required in the current manual of survey instructions of the United States Department of the Interior, Bureau of Land Management or by a decree of a Court of Law and/or that the corner points mentioned in lines 3, 4 and 5 above were in conformance with the rules of the Michigan Board of Land Surveyors or by a Decree of a Court of Law; established, re-established, monumented, re-monumented, recovered, found as expressed below:

NOTE: Not more than 4 corners, all in the same town and range, may be recorded on this certificate.


A. Description of original monument and accessories and/or subsequent restoration:

Original Government Post set by Hervey Parke, Deputy Surveyor, February 1824.  
 W. Oak 16" N 8 E 37 links (24.42') 39.92 1/2 chains to 1/4 post  
 Y. Oak 18" S 10 W 57 links (37.62') 79.85 chains to Section corner  
 Perpetuation by B. F. LaRue, November 1884  
 W. Oak 8" S 84 3/4 W 23 1/2 links (15.51')  
 \* W. Oak 6" N 76 1/4 W 36 links (23.76')  
 Found Stone at corner and remains of both witnesses.  
 Fireclay (3" diameter X 24")  
 lime under fireclay

Continued on back,

B. Description of corner evidence found and/or method applied in restoring or reestablishing corner:

Found FIRECLAY, 6" below surface of Fishville Road (gravel). Found lime below fireclay.  
 Corner is in line of fence West and hedge East and 7' West of center line of gravel.  
 Accepted FIRECLAY, as a careful and faithful perpetuation of the position of the original corner, as remonumented by LaRue in 1884. Set a Standard Jackson County Monument and left broken fireclay buried on North & South side of monument.

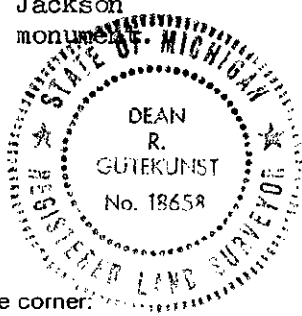

C. Description of monument for corner and accessories established to perpetuate locating the position of the corner:

J-11 T3S, R2E Corner is a 4" diameter X 36" concrete monument with a 1/2" X 36" steel rod and an aluminum cap stamped LS 18658, which is the standard monument for Jackson County.

\* N 76 1/4 W 32" Oak 23.76' 40d & washer on South side  
 \*\* N 7 30 W 22" W. Oak 84.20' 40d & washer on East side  
 N 15 E 20" Sassafras 120.33' 40d & washer on East side  
 East Double 1 1/2" Oak 58.20' no nail, center of tree  
 S 30 E Amoco Pipeline post (where 5/8" rod footstep enters post) 57.97'  
 West Steel post with survey marker sign attached 20'

Signed by Dean R. Gutekunst

Date December 22, 1995

Surveyor's Michigan License No. 18658

A. Continued,

- Perpetuation by Fred C. Riley, # 377, 1936
  - Fireclay, OK, top broken off
  - In line of fence East and 4" below surface
  - 4.5' West of center line of traveled road.
- \*\* W. Oak 14"      N 7°30' W      84.20'

- Not recorded in P. A. 74

SURVEY &  
REMONUMENTATION

NOV 03 1999

SECTION