

Chairman Alan L. Scheppelman
 Date Nov. 13, 1996

LAND CORNER RECORDATION CERTIFICATE
 Filing Requirement of Act 74, Mich. P.A. 1970

#2021160
 Liber 1532 Page 432
 Page 1 of 1
 Jackson Co., MI
 Recorded
 11-15-96 02:13P
 Kelly McDevitt
 Register of Deeds

Jackson (County)	Located In:	Corner Code #
1. Public Land Survey	T 3S R2W	C-8
	T _____ R _____	_____
	T _____ R _____	_____
	T _____ R _____	_____
2. Property Controlling in Section	S _____ T _____ R _____	_____
	S _____ T _____ R _____	_____
3. Miscellaneous Property in Sec.	S _____ T _____ R _____	_____
	S _____ T _____ R _____	_____

Register of Deeds Stamp & File Number

4. Lot No. _____, Recorded Plat _____
 5. Private Claims _____

	A	B	C	D	E	F	G	H	I	J	K	L	M
2	6		5		4		3		2		1		
3													
4	7		8		9		10		11		12		
5													
6	18		17		16		15		14		13		
7													
8	19		20		21		22		23		24		
9													
10	30		29		28		27		26		25		
11													
12	31		32		33		34		35		36		
13													

Alan L. Scheppelman in a field survey on May 14, 1996, do hereby certify that under requirements of P.A. 74, Michigan P.A. of 1970, the corner points mentioned in lines 1 and 2 above were in conformance with regulations and rules therefore as required in the current manual of survey instructions of the United States Department of the Interior, Bureau of Land Management or by a decree of a Court of Law and/or that the corner points mentioned in lines 3, 4 and 5 above were in conformance with the rules of the Michigan Board of Land Surveyors or by a Decree of a Court of Law; established, re-established, monumented, re-monumented, recovered, found as expressed below:

NOTE: Not more than 4 corners, all in the same town and range, may be recorded on this certificate.


A. Description of original monument and accessories and/or subsequent restoration:

LUCIUS LYON, D.S. 40.00 SET QUARTER SECTION POST - SECTIONS 19 & 20
 MARCH 3-12, 1825 RED OAK 22, S45°E 53 LINKS (34.98')
 WHITE OAK 19, S19°W 47 LINKS (31.02')

H.F. BEAN POST AND ONE WITNESS STANDING
 MAY-JUNE, 1886 BURR OAK 12", S48°W 220 LINKS (145.20') (*270 LKS = 178.20')
 BURR OAK 12", S30°W 327 1/2 LINKS (216.15')

B. Description of corner evidence found and/or method applied in restoring or reestablishing corner:

USED BEAN'S WITNESSES TO DETERMINE SEARCH AREA. EXCAVATED AN AREA 4' X 8' AND 1.5' DEEP AND FOUND BOTTOM 12" OF A BROKEN FIRECLAY. IT WAS UNDISTURBED AND DOWN 1.0' IN A FARM FIELD. BEAN'S FIRST WITNESS MEASURES LONG BY 33' AND THE SECOND WITNESS AGREES FOR DISTANCE BUT NOT DIRECTION. ACCEPTED THE BOTTOM 1/2 OF THE FIRECLAY AS A CAREFUL AND FAITHFUL PERPETUATION OF THE POSITION OF THE ORIGINAL CORNER AS REMONUMENTED BY BEAN. SET STANDARD JACKSON COUNTY MONUMENT AND BURIED THE FIRECLAY ON THE NORTH SIDE.

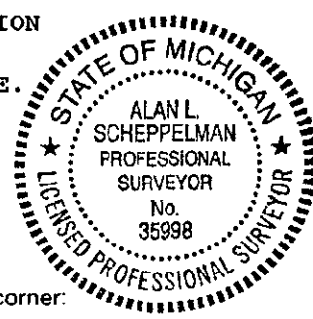

C. Description of monument for corner and accessories established to perpetuate locating the position of the corner:

4" X 36" CONCRETE MONUMENT WITH JACKSON COUNTY REMONUMENTATION CAP STAMPED
 "C-8 T3S R2W LS 35998" 1.0' BELOW GROUND IN FARM FIELD.
 S83°E NAIL & TAG #35998 IN N. SIDE OF RR TIE FENCE CORNER POST 171.16'
 S39°W NAIL & TAG #35998 IN SE SIDE OF 44" OAK 218.34' (BEAN)
 S50°W NAIL & TAG #35998 IN SE SIDE OF 40" OAK 177.50' (BEAN)
 N49°W NAIL & TAG #35998 IN NE SIDE OF 18" OAK 106.05'

Signed by Alan L. Scheppelman Date 06/24/96
 Surveyor's Michigan License No. 35998