

Chairman Dean R. Gutzmer
Date Dec 13, 1995

LAND CORNER RECORDATION CERTIFICATE
Filing Requirement of Act 74, Mich. P.A. 1970

For corners in Jackson Located In: _____ Corner Code # _____
(County)

LIBER 1509 PAGE 1070

- | | | |
|--------------------------------------|-------------------------|------------|
| 1. Public Land Survey | T <u>3S</u> R <u>2W</u> | <u>G-9</u> |
| | T _____ R _____ | _____ |
| | T _____ R _____ | _____ |
| | T _____ R _____ | _____ |
| 2. Property Controlling in Section | S _____ T _____ R _____ | _____ |
| | S _____ T _____ R _____ | _____ |
| 3. Miscellaneous Property in Section | S _____ T _____ R _____ | _____ |
| | S _____ T _____ R _____ | _____ |

Register of Deeds Stamp & File Number

4. Lot No. _____, Recorded Plat _____
5. Private Claims _____

A	B	C	D	E	F	G	H	I	J	K	L	M
2	6	5	4	3	2	1						
3												
4	7	8	9	10	11	12						
5												
6	18	17	16	15	14	13						
7												
8	19	20	21	22	23	24						
9												
10	30	29	28	27	26	25						
11												
12	31	32	33	34	35	36						
13												

I, Fred N. White, in a field survey on November 25, 1995, do hereby certify that under requirements of P.A. 74, Michigan P.A. of 1970, the corner points mentioned in lines 1 and 2 above were in conformance with regulations and rules therefore as required in the current manual of survey instructions of the United States Department of the Interior, Bureau of Land Management or by a decree of a Court of Law and/or that the corner points mentioned in lines 3, 4 and 5 above were in conformance with the rules of the Michigan Board of Professional Surveyors or by a Decree of a Court of Law; established, re-established, monumented, re-monumented, recovered, found as expressed below:

NOTE: Not more than 4 corners, all in the same town and range, may be recorded on this certificate.

A. Description of original monument and accessories and/or subsequent restoration:

Original Government Post set by Lucius Lyon, U.S. Deputy Surveyor, March 1825.
S 32 E, Y. Oak 20", 50 Links (33.00 Feet)
S 72°W, Y. Oak 22", 67 Links (44.22 Feet)
Perpetuation by H.F. Bean, June 1886
N 25 1/4 E, W. Oak 24", 80 1/2 Links (53.13 Feet)
S 72 1/2 E, W. Oak 20", 8 1/2 Links (5.61 Feet)
Found original post hole and stake set 1866±
Set 3" x 24" Fireclay

CONTINUED ON OTHER SIDE

STATE OF MICHIGAN
JACKSON COUNTY
REGISTERED

28 FEB 96 2:41 P.M.

B. Description of corner evidence found and/or method applied in restoring or reestablishing corner:


GERALD L. McDEVITT
REGISTER OF DEEDS

Found 3/4" capped iron #7863 from (2) remaining witnesses in an East-West fence line, excavated and found brick, stone & 2 fireclays, one over the top of the other with 0.6 separation between the two, accepted the position of the fireclays as the perpetuated corner as set by H.F. Bean. Set 4" x 36" concrete monument with 1/2" rebar and Jackson County Cap.

\$ 2.00 REMONUMENTATION
\$ 9.00 CORNER REMONUMENTATION

C. Description of monument for corner and accessories established to perpetuate locating the position of the corner:

4" x 36" STANDARD JACKSON COUNTY MONUMENT
STAMPED "G-9 T3S R2W LS NO. 12034"
N13°W Nail & Tag #7863 East Side, 20" Oak, 53.52'
N42°W Nail & Tag #12034 Northeast Side, 24" Oak, 29.35'
WEST Nail & Tag #12034 North Side, 16" Cherry, 1.07'
N41°E Nail & Tag #12034 Southeast Side, 16" Cherry, 30.78'
West 1/2" x 18" Iron Bar 2.0'
South 1/2" x 18" Iron Bar 2.0'

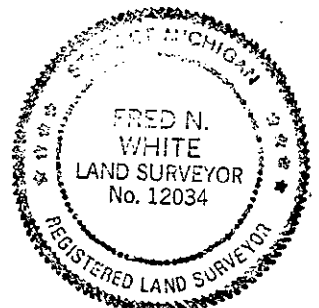

Signed by Fred N. White
Surveyor's Michigan License No. 12034

Date NOVEMBER 27, 1995

A. DESCRIPTION OF ORIGINAL MONUMENT AND ACCESSORIES AND/OR SUBSEQUENT RESTORATION:

L.C.R.C. dated February 25, 1975 by R.E. Gutekunst #07863. Recorded in Liber 2, Page 580, cited additional county surveyor witnesses:

N 15°W, Dbl. W. Oak 9", 53.2' (*)

N 25°W, W. Oak 12", 14.7' (*)

N 80°W, Y. Oak, 18.4'

Found Fireclay F.A. Fisher 1923 4' Found Fireclay with brick and stones around from 2 old witnesses (*), Set 3/4 x 18" capped iron on North side.'

N25°W 28" W. Oak, 15.14' (gone 1995)

N10°W 20" & 10" W. Oak, 53.5' (found 1995)

N45°W 24" B. Oak 29.37' (found 1995)

N60°W 18" W. Oak 42.76' (gone 1995)

N50°E 12" Hickory, 61.79' (gone 1995)

East 16" Cherry, 19.34' (gone 1995)