

**JACKSON COUNTY**  
**APPROVED LAND CORNER**  
**P.A. 345 of 1990**

Chairman Dean Gutekunst SECTION CORNER SECTION 33 SPRING ARBOR TOWNSHIP  
 Date SEPT. 10, 1997  
**LAND CORNER RECORDATION CERTIFICATE**  
 Filing Requirement of Act 74, Mich. P.A. 1970

#2046615  
 Liber 1550 Page 931  
 Page 1 of 1  
 Jackson Co., MI  
 Recorded  
 09/10/97 12:50P  
 Mindy Reilly  
 Register of Deeds

For corners in

<u>JACKSON</u> (County)	Located In:	Corner Code #
1. Public Land Survey	T <u>3S</u> R <u>2W</u>	<u>G-13</u> SURVEY & REMONUMENTATION
	T _____ R _____	
	T _____ R _____	
	T _____ R _____	
2. Property Controlling in Section	S _____ T _____ R _____	<u>APR 07 1998</u>
	S _____ T _____ R _____	
3. Miscellaneous Property in Sec.	S _____ T _____ R _____	SECTION
	S _____ T _____ R _____	

Register of Deeds Stamp & File Number

4. Lot No. \_\_\_\_\_, Recorded Plat \_\_\_\_\_  
 5. Private Claims \_\_\_\_\_

	A	B	C	D	E	F	G	H	I	J	K	L	M
2	6	5	4	3	2	1							
3													
4	7	8	9	10	11	12							
5													
6	18	17	16	15	14	13							
7													
8	19	20	21	22	23	24							
9													
10	30	29	28	27	26	25							
11													
12	31	32	33	34	35	36							
13													

RONALD L. ENGER, in a field survey on DECEMBER 17, 1992

do hereby certify that under requirements of P.A. 74, Michigan P.A. of 1970, the corner points mentioned in lines 1 and 2 above were in conformance with regulations and rules therefore as required in the current manual of survey instructions of the United States Department of the Interior, Bureau of Land Management or by a decree of a Court of Law and/or that the corner points mentioned in lines 3, 4 and 5 above were in conformance with the rules of the Michigan Board of Land Surveyors or by a Decree of a Court of Law; established, re-established, monumented, re-monumented, recovered, found as expressed below:

**NOTE: Not more than 4 corners, all in the same town and range, may be recorded on this certificate.**

1. Description of original monument and accessories and/or subsequent restoration:

POST SET IN ORIGINAL GOVERNMENT SURVEY BY LUCIUS LYON, DEPUTY SURVEYOR IN 1825 AND 2 BEARING TREES RECORDED: W. OAK 15 N69W 63 (41.6') AND W. OAK 15 N21E 55 (36.3'). ROBERT CLARK, JR., DEPUTY SURVEYOR, SUBDIVISION OF T4S, R2W, ESTABLISHED NEARBY CLOSING CORNER AND NOTED "INT. N. BOUND. 68 LKS. (44.9') E. OF STK.". BETWEEN MAY 12, 1886 AND JUNE 12, 1886, H.F. BEAN REPORTED "RED CEDAR POST AND TWO WITNESSES STANDING" AND RECORDED 2 WITNESSES: W. OAK 15" N69W 63 (41.6') AND W. OAK 15" N21E 55 (36.3').


2. Description of corner evidence found and/or method applied in restoring or reestablishing corner:

SEARCHED IN OLD EAST-WEST FENCELINE (MOSTLY DOWN) AT GLO FALLING DISTANCE (44.9') WEST OF FIRECLAY POST AT G-1 T4S R2W. FOUND 3" DIAMETER FIRECLAY POST, TOP BURIED ABOUT 0.3' BELOW GROUND SURFACE IN PERFECT CONDITION. FOUND NO EVIDENCE OF THE GLO OR BEAN ACCESSORIES. ACCEPTED THE FIRECLAY POST AS BEAN'S PERPETUATION OF THE CORNER POINT. MADE TEMPORARY WITNESSES AND EXCAVATED TO MAKE WAY FOR NEW MARKER. EXCAVATED MATERIAL ALL SAND, FOUND NO STONES OR BRICK. SET CONCRETE MONUMENT WITH ALUMINUM CAP AT CORNER POINT. PLACED THE FC POST IN THE HOLE AT NORTH SIDE OF THE CONCRETE MONUMENT.

APP. ACT 345 PEER REVIEW GROUP, DEAN GUTEKUNST, CO. SURVEYOR \_\_\_\_\_

3. Description of monument for corner and accessories established to perpetuate locating the position of the corner:

- G-13, T3S R2W
- 3" DIAMETER X 34" CONCRETE MONUMENT WITH 1/2" X 36" REBAR AND JACKSON COUNTY STANDARD CAP (HAS MAGNET) STAMPED LS 28409
- 0° NAZ, 15" OAK, 65.06', 40D SPIKE IN EAST SIDE
- 4° NAZ, FIRECLAY POST (G-1, T4S, R2W), 44.94'
- 5° NAZ, 8" SASSAFRAS, 11.10', 40D SPIKE IN N. SIDE
- 60° NAZ, 18" OAK, 16.17', 40D SPIKE IN EAST SIDE
- 91° NAZ, 9" OAK, 16.33', 40D SPIKE IN WEST SIDE
- 00° NAZ, 4" MAPLE, 6.25', 16D DBL HEAD NAIL & SHINER IN S. SIDE
- 46° NAZ, 17" OAK, 59.40', 40D SPIKE IN WEST SIDE

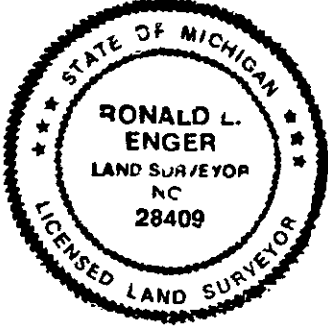

signed by Ronald L. Enger Date DECEMBER 21, 1992  
 Surveyor's Michigan License No. 28409

Record 274