

**JACKSON COUNTY  
APPROVED LAND CORNER  
P.A. 345 of 1990**

Chairman *Near [Signature]*

Date May 15, 1997

**SOUTHEAST CORNER, SECTION 14, SPRING ARBOR TWP.  
LAND CORNER RECORDATION CERTIFICATE  
Filing Requirement of Act 74, Mich. P.A. 1970**

#2035212  
Liber 1542 Page 562  
Page 1 of 1  
Jackson Co., MI  
Recorded  
05/15/97 10:51A  
Mindy Reilly  
Register of Deeds

For corners in

Jackson  
(County)

Located in:

Corner Code #

**SURVEY &  
REMONUMENTATION**

APR 07 1998

SECTION

Register of Deeds Stamp & File Number

1. Public Land Survey

T 3 S R 2 W

K-7

T \_\_\_ R \_\_\_

T \_\_\_ R \_\_\_

T \_\_\_ R \_\_\_

2. Property Controlling  
in Section

S \_\_\_ T \_\_\_ R \_\_\_

S \_\_\_ T \_\_\_ R \_\_\_

3. Miscellaneous  
Property in Sec.

S \_\_\_ T \_\_\_ R \_\_\_

S \_\_\_ T \_\_\_ R \_\_\_

4. Lot No. \_\_\_\_\_, Recorded Plat \_\_\_\_\_

5. Private Claims \_\_\_\_\_

I, Michael A. Groat, in a field survey on May 13, 1997 do hereby state that under requirements of P.A. 74, Michigan P.A. of 1970, the corner points mentioned in lines 1 and 2 above were in conformance with regulations and rules therefore as required in the current manual of survey instructions of the United States Department of the Interior, Bureau of Land Management or by a decree of a Court of Law and for that the corner points mentioned in lines 3, 4 and 5 above were in conformance with the rules of the Michigan Board of Land Surveyors or by a Decree of a Court of Law; established, re-established, monumented, recovered, found as expressed below:

NOTE: Not more than 2 corners, all in the same town and range, may be recorded on this certificate.

	A	B	C	D	E	F	G	H	I	J	K	L	M
1													
2	6		5		4		3		2		1		
3													
4	7		8		9		10		11		12		
5													
6	10		17		16		15		14		13		
7											⊕		
8	19		20		21		22		23		24		
9													
10	30		29		28		27		26		25		
11													
12	31		32		33		34		35		36		
13													

A. Description of original monument and accessories and/or subsequent restoration:

Original Survey by Lucius Lyon, deputy surveyor in 1825, set post in marsh, Tam. 18" S42½°W, 419 Links; Tam., 14", N66½°E, 283 Links

H.F. Bean, 1886, Found part of post and 2 witnesses standing, set fireclay tile, Tam., 12", N33°E, 70¾ Links; Elm, 3", N73½°E, 227 Links

Consumers Power Co. information states that a iron was found in a monument box, T.P., S45°E, 44.50'; 8" Elm, S30°E, 82.80'; 14" Oak, N35°E, 74.70'

Harold W. Dorsey, P.S. #9429, in L.C.R.C. dated April-May, 1972 and recorded in Liber 1 on page 127, says he found a iron in a monument box but gives no witnesses.

B. Description of corner evidence found and/or method applied in restoring or reestablishing corner:


Found a 1" pipe in a monument box 2' West of centerline. Excavated and found pieces of fireclay 2' deep and @ 3.5' deep found bottom portion of fireclay in good condition. Accepted this position as a careful and faithful perpetuation of the original corner. Set a 4"x36" concrete monument over bottom portion of fireclay.

C. Description of monument for corner and accessories established to perpetuate locating the position of the corner:

The corner is a standard Jackson County concrete monument in monument box with corner code and Township information stamped in the cap.

Witnesses:

N40°E	Nail and tag in Southeasterly side of 20" White oak	74.70'
N60°W	Nail and tag in Northerly side of 8" Maple	94.00'
S82°E	Nail and tag in South side of utility pole	32.38'
S5°E	Nail and tag in West side of utility pole	309.0'
West	Survey marker sign post	22.00'

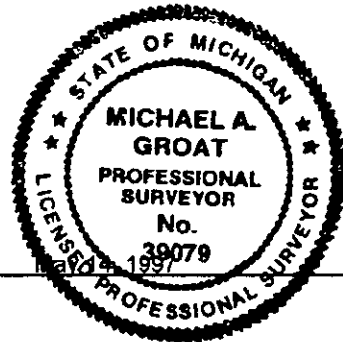

Signed by *Michael A. Groat* Date May 15, 1997

Surveyor's Michigan License No. 39079