

Chairman [Signature]  
 Date Dec. 20, 1994

LAND CORNER RECORDATION CERTIFICATE  
 Filing Requirement of Act 74, Mich. P.A. 1970

For corners in  
 Jackson  
 (County)

Located in: Corner Code #

- 1. Public Land Survey T 3S R 2W
- 2. Property Controlling in Section S T R
- 3. Miscellaneous Property in Sec. S T R

K-9  
 SURVEY &  
 REMONUMENTATION  
 MAY 03 1995  
 COMMISSION

STATE OF MICHIGAN  
 JACKSON COUNTY  
 REGISTERED  
 30 DEC 94 11:20 A.M.  
 GERALD J. McDEVITT  
 REGISTER OF DEEDS

Register of Deeds Stamp & File Number

- 4. Lot No. \_\_\_\_\_, Recorded Plat \_\_\_\_\_
- 5. Private Claims \_\_\_\_\_

Arden S. Pierson PS September 13 1994

I, \_\_\_\_\_, in a field survey on \_\_\_\_\_, 19 \_\_\_\_\_, do hereby certify that under requirements of P.A. 74, Michigan P.A. of 1970, the corner points mentioned in lines 1 and 2 above were in conformance with regulations and rules therefore as required in the current manual of survey instructions of the United States Department of the Interior, Bureau of Land Management or by a decree of a Court of Law and/or that the corner points mentioned in lines 3, 4 and 5 above were in conformance with the rules of the Michigan Board of Land Surveyors or by a Decree of a Court of Law; established, re-established, monumented, re-monumented, recovered, found as expressed below:

NOTE: Not more than 4 corners, all in the same town and range, may be recorded on this certificate.

	A	B	C	D	E	F	G	H	I	J	K	L	M
2	6	5	4	3	2	1							
3													
4	7	8	9	10	11	12							
5													
6	18	17	16	15	14	13							
7													
8	19	20	21	22	23	24							
9													
10	30	29	28	27	26	25							
11													
12	31	32	33	34	35	36							
13													

A. Description of original monument and accessories and/or subsequent restoration:  
 K-9 - Original survey by Lucius Lyon DS, 1825, County Surveyor records show he set a post as the corner, with witnesses:  
 22" W. Oak -S85°W- 5 links 18" W. Oak -N53°E- 61 links  
 County Surveyor records also show in a survey by H.F. Bean, dated May - June of 1886, that he set a fireclay post with witnesses:  
 12" Hickory -N12½°W- 62 2/3 links(41.36')  
 30" W. Oak -S23°W- 89 1/2 links(59.07')

\$ 2.00 REMONUMENTATION  
 \$ 9.00 CORNER REMONUMENTATION

\*(BACK OF SHEET)

B. Description of corner evidence found and/or method applied in restoring or reestablishing corner:

Section 25, Spring Arbor Township

K-9 - Found 3/4" pipe in monument box 8' West of centerline of road. Dug down and found fireclay with the top 4" missing, with brick pieces around the bottom - And accepted as a careful and faithful perpetuation of the position of the original corner. Replaced fireclay with Standard Jackson County Monument 3" below the top of monument box and placed fireclay on North side of the monument with pieces of brick around the top of it.

C. Description of monument for corner and accessories established to perpetuate locating the position of the corner.


K-9 (NW corner Section 25)  
 Jackson County Monument

- Nail & tag #13039 N. side Railroad tie post -S60°E- 70.15'
- Nail & tag #13039 W. side Railroad tie post -S40°E- 77.79'
- Nail & tag #13039 E. side 27" W. Cherry -N15°W- 92.22'
- Nail & tag #13039 SW side 7" Walnut -N50°W- 63.31'

\*Standard Jackson Monument is a 1/2" iron rod 36" long with a Jackson County Remonumentation disk encased in a 4" concrete cylinder.

Signed by Arden S. Pierson Date November 1, 1994

Surveyor's Michigan License No. 13039

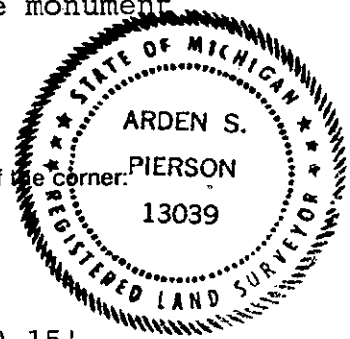

**NW CORNER OF SECTION 25, SPRING ARBOR TOWNSHIP**

Certification by H.F. Bean (page 620, GLO Notes)  
"post set are fireclay, three inches in diameter and two feet long"

Jackson County Road Commission Records from 1961 show the the following witnesses for K-9:

Iron in Road

24" Elm -N45°W- 42.20'

30" Elm -S45°W- 44.30'

14" Oak -S45°W- 57.10'

Recorded in Liber 1, page 127, by Harold W. Dorcey PS #9429, dated June 12, 1972. He states that he found the monument box, but did not witness.