

**JACKSON COUNTY  
APPROVED LAND CORNER**

**P.A. 345 of 1970**  
ACTING  
Chairman  
*[Signature]*  
For corners in  
Date 02-12-97  
*[Signature]*

WEST 1/4 POST SECTION 15  
CONCORD TOWNSHIP

**LAND CORNER RECORDATION CERTIFICATE**  
Filing Requirement of Act 74, Mich. P.A. 1970

#2028015  
Liber 1537 Page 323  
Page 1 of 2  
Jackson Co., MI  
Recorded  
02/21/97 09:41A  
Mindy Reilly  
Register of Deeds

For corners in JACKSON (County) Located in: \_\_\_\_\_ Corner Code # \_\_\_\_\_

1. Public Land Survey T 3 S R 3 W  
T \_\_\_\_\_ R \_\_\_\_\_  
T \_\_\_\_\_ R \_\_\_\_\_  
T \_\_\_\_\_ R \_\_\_\_\_

2. Property Controlling S \_\_\_\_\_ T \_\_\_\_\_ R \_\_\_\_\_  
in Section S \_\_\_\_\_ T \_\_\_\_\_ R \_\_\_\_\_

3. Miscellaneous S \_\_\_\_\_ T \_\_\_\_\_ R \_\_\_\_\_  
Property in Sec. S \_\_\_\_\_ T \_\_\_\_\_ R \_\_\_\_\_

4. Lot No. \_\_\_\_\_ Recorded Plat \_\_\_\_\_

5. Private Claims \_\_\_\_\_

**SURVEY &  
REMONUMENTATION**  
G-6  
APR 07 1998  
SECTION

Register of Deeds Stamp & File Number


I, Dean R. Gutekunst, in a field survey on 5/15/95 & 8/23/95, 19  , do hereby certify that under requirements of P.A. 74, Michigan P.A. of 1970, the corner points mentioned in lines 1 and 2 above were in conformance with regulations and rules therefore as required in the current manual of survey instructions of the United States Department of the Interior, Bureau of Land Management or by a decree of a Court of Law and/or that the corner points mentioned in lines 3, 4 and 5 above were in conformance with the rules of the Michigan Board of Land Surveyors or by a Decree of a Court of Law; established, re-established, monumented, re-monumented, recovered, found as expressed below:

| A  | B  | C  | D  | E  | F  | G  | H | I | J | K | L | M |
|----|----|----|----|----|----|----|---|---|---|---|---|---|
| 2  | 6  | 5  | 4  | 3  | 2  | 1  |   |   |   |   |   |   |
| 3  |    |    |    |    |    |    |   |   |   |   |   |   |
| 4  | 7  | 8  | 9  | 10 | 11 | 12 |   |   |   |   |   |   |
| 5  |    |    |    |    |    |    |   |   |   |   |   |   |
| 6  | 18 | 17 | 16 | 15 | 14 | 13 |   |   |   |   |   |   |
| 7  |    |    |    |    |    |    |   |   |   |   |   |   |
| 8  | 19 | 20 | 21 | 22 | 23 | 24 |   |   |   |   |   |   |
| 9  |    |    |    |    |    |    |   |   |   |   |   |   |
| 10 | 30 | 29 | 28 | 27 | 26 | 25 |   |   |   |   |   |   |
| 11 |    |    |    |    |    |    |   |   |   |   |   |   |
| 12 | 31 | 32 | 33 |    |    |    |   |   |   |   |   |   |
| 13 |    |    |    |    |    |    |   |   |   |   |   |   |

NOTE: Not more than 4 corners, all in the same town and range, may be recorded on this certificate.

A. Description of original monument and accessories and/or subsequent restoration:

Original Government Post set by Lucius Lyon, Deputy Surveyor, April 1825.  
White Oak 11" S 67 W 57 links (37.62')  
White Oak 10" N 68 W 39 links (25.74')  
No perpetuation found for the 1880's.  
Perpetuation by the Jackson County Road Commission, no name or date.  
\* 6" R. Oak S 40 E 55.2'  
\*\* 10" Oak N 85 W 70.3' Large stone with "V" in top.  
\*\*\* 18" B. Oak S 80 E 46.5'

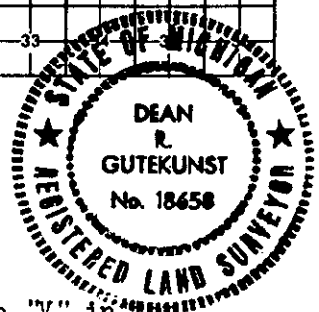

B. Description of corner evidence found and/or method applied in restoring or reestablishing corner:

Found STONE (12" X 12" X 15") with "V" notch on top, 2' below gravel surface of French Road, with an iron over stone to surface.  
Backhoe excavation of a 7' X 13' X 6' deep area to find stone and reset to 5' below surface. Also piled rocks 4" to 12" in size around stone. Left iron and several pieces of broken white crockery, found in excavation, on top of stone.  
Corner is on center line of French Road (gravel) and in line of hedge row and fence running West and hedge East.  
Accepted stone as a careful and faithful perpetuation of the position of the original corner as recovered by the Jackson County Road Commission.  
Set a Standard Jackson County Monument, to replace stone, and left stone buried under monument.

C. Description of monument for corner and accessories established to perpetuate locating the position of the corner:

G-6 T3S, R3W Corner is a 4" diameter X 36" concrete monument with a 1/2" X 36" steel rod and an aluminum cap stamped LS 18658, which is the standard monument for Jackson County.  
\* S 30° E 18" R. Oak 54.32' 40d & washer on West side.  
\*\* N 85° W 30" R. Oak 70.25' 40d & washer on North side.  
\*\*\* S 88° E 30" B. Oak 46.62' 40d & washer on South side.  
\*\*\*\* N 80° W 18" Oak 59.40' 40d & washer on North side.  
\*\*\*\*\* N 60° W 22" Oak 25.85' 40d & washer on Northeast side.  
S 50° E 14" Maple 80.73' 40d & washer on Southwest side.  
S 85° E Northwest corner foundation of house 140.34'  
N 15° W 17" Oak 118.88' 40 d & washer on East side.  
West Steel post and survey marker sign attached 33'

Signed by Dean R. Gutekunst Date February 1, 1997  
Surveyor's Michigan License No. 18658

Record 328