

P.A. 345 of 1990
 Chairman *David E. Euland*
 Date 7-9-97

#2040667
 Liber 1546 Page 463
 Page 1 of 2
 Jackson Co., MI
 Recorded
 07/09/97 01:14P
 Mindy Reilly
 Register of Deeds

LAND CORNER RECORDATION CERTIFICATE
Filing Requirement of Act 74, Mich. P.A. 1970


For corners in
JACKSON
 (County)

Located In:	Corner Code #
T 4 S R 1 E	I-13
T — R —	_____
T — R —	_____
T — R —	_____
T — R —	_____
S — T — R —	_____
S — T — R —	_____
S — T — R —	_____
S — T — R —	_____

SURVEY & REMONUMENTATION
APR 07 1998
SECTION
Register of Deeds Stamp & File Number

- 1. Public Land Survey
- 2. Property Controlling in Section
- 3. Miscellaneous Property in Sec.

- 4. Lot No. _____, Recorded Plat _____
- 5. Private Claims _____

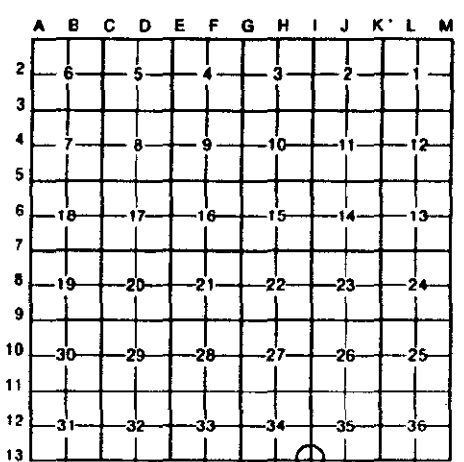

DEAN R. GUTEKUNST, in a field survey on Sept. 24, 1996 & May 19, 1997


do hereby certify that under requirements of P.A. 74, Michigan P.A. of 1970, the corner points mentioned in lines 1 and 2 above were in conformance with regulations and rules therefore as required in the current manual of survey instructions of the United States Department of the Interior, Bureau of Land Management or by a decree of a Court of Law and/or that the corner points mentioned in lines 3, 4 and 5 above were in conformance with the rules of the Michigan Board of Land Surveyors or by a Decree of a Court of Law, established, re-established, monumented, re-monumented, recovered, found as expressed below:

NOTE: Not more than 4 corners, all in the same town and range, may be recorded on this certificate.

Description of original monument and accessories and/or subsequent restoration:

- Original Government Post set by Benjamin Hough, Deputy Surveyor, 1815.
- B. Oak 14" N 88 E 35 links (23.10')
- E. Oak 12" N 13 W 31 links (20.46')
- Perpetuation by P. T. Cook, no date.
- Y. Oak 8" N 13 W 35 links (23.10')
- Hickory 18" S 40 1/2 E 42 1/2 links (28.05')

Found old remains of stake.

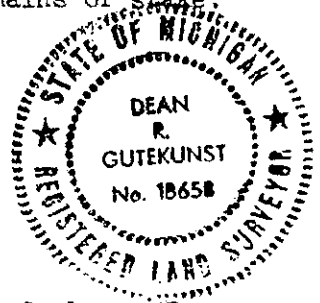

Continued on back,

Description of corner evidence found and/or method applied in restoring or reestablishing corner:

- Found iron, from above information.
- Found iron 42.22' East for Lenawee Corner.
- Backhoe excavation, 9/24/96, of areas, did not find stone at either the Jackson or Lenawee Corners.
- Corner is 5.8'± South of center line of Taylor Road (blacktop), 5/19/1997
- Accepted iron, at surface, as a careful and faithful perpetuation of the position of the original corner, as monumented by the Stone and found by Riley in 1916.
- Set a Standard Jackson County Monument, to replace the iron, on May 19, 1997.

Description of monument for corner and accessories established to perpetuate locating the position of the corner:

- I-13 T4S, R1E Corner is a 4" diameter X 30" Cast Iron Harrison monument with a brass cap stamped LS 18658, which is a standard monument for Jackson County.
- ** S 67°E 30" W. Oak 75.96' 40d and washer on North side.
- *** S 5°W 26" Hickory 27.57' 40d and washer over 60d on West side.
- S 80°W 22" Oak (double-East of 2) 80.27' 40d and washer on West side.
- N 10°W 12" Oak 43.49' 40d and washer on West side.
- N 60°W 14" Oak 113.03' 40d and washer on South side.
- S 35°E 32" Oak 85.94' 40d and washer on West side.
- East Iron in monument box 42.22' Northwest corner of Section 2, T5S, R1E.
- Monument box set by Jackson County Road Commission.

Recorded by *Dean R. Gutekunst* Date July 1, 1997
 Surveyor's Michigan License No. 18658

Decord 367