

**JACKSON COUNTY**  
**APPROVED LAND CORNER**  
**P.A. 345 of 1990**

SOUTH  $\frac{1}{4}$  POST, SECTION 35  
 COLUMBIA TOWNSHIP

**LAND CORNER RECORDATION CERTIFICATE**  
**Filing Requirement of Act 74, Mich. P.A. 1970**

#2040668  
 Liber 1546 Page 464  
 Page 1 of 2  
 Jackson Co., MI  
 Recorded  
 07/09/97 01:15P  
 Mindy Reilly  
 Register of Deeds

For corners in  
JACKSON  
 (County)

Located In:

Corner Code #

**SURVEY &  
 J-13 REMONUMENTATION**

APR 07 1998

**SECTION**

**Register of Deeds Stamp & File Number**

- |                                    |   |     |   |     |
|------------------------------------|---|-----|---|-----|
| 1. Public Land Survey              | T | 4 S | R | 1 E |
|                                    | T |     | R |     |
|                                    | T |     | R |     |
|                                    | T |     | R |     |
| 2. Property Controlling in Section | S |     | T | R   |
|                                    | S |     | T | R   |
| 3. Miscellaneous Property in Sec.  | S |     | T | R   |
|                                    | S |     | T | R   |

4. Lot No. \_\_\_\_\_, Recorded Plat \_\_\_\_\_  
 5. Private Claims \_\_\_\_\_

	A	B	C	D	E	F	G	H	I	J	K	L	M
2	6		5		4		3		2		1		
3													
4	7		8		9		10		11		12		
5													
6	18		17		16		15		14		13		
7													
8	19		20		21		22		23		24		
9													
10	30		29		28		27		26		25		
11													
12	31		32		33		34		35		36		
13													

DEAN R. GUTEKUNST, in a field survey on Sept. 24, 1996 & May 19, 1997

do hereby certify that under requirements of P.A. 74, Michigan P.A. of 1970, the corner points mentioned in lines 1 and 2 above were in conformance with regulations and rules therefore as required in the current manual of survey instructions of the United States Department of the Interior, Bureau of Land Management or by a decree of a Court of Law and/or that the corner points mentioned in lines 3, 4 and 5 above were in conformance with the rules of the Michigan Board of Land Surveyors or by a Decree of a Court of Law; established, re-established, monumented, re-monumented, recovered, found as expressed below:

**NOTE: Not more than 4 corners, all in the same town and range, may be recorded on this certificate.**

**A. Description of original monument and accessories and/or subsequent restoration:**

- Original Government Post set by Benjamin Hough, Deputy Surveyor, 1815.  
 B. Oak 12" N 87 W 179 links (118.14')  
 W. Oak 22" N 73 E 143 links (94.38')  
 Perpetuation by P.T. Cook, no date.  
 Y. Oak 8" S 35 $\frac{1}{4}$  E 156  $\frac{3}{4}$  links (103.455')  
 Locust 4" N 80 $\frac{1}{2}$  W 107 $\frac{1}{4}$  links (70.785')

Stone corner, kept up.


Continued on back,

**3. Description of corner evidence found and/or method applied in restoring or reestablishing corner:**

Found iron to surface of Taylor Road (gravel) and also iron East 8.73' for Lenawee County. Backhoe excavation, 9/24/1996, of a 5' X 12' X 7' deep area, did not find stone or any additional information. At 7' depth found 24" diameter logs crosswise to the road and could not excavate deeper.

Corner is 5.4' South of the center line of Taylor Road (blacktop) and in line of fence North. Accepted the iron, at surface, as a careful and faithful perpetuation of the position of the corner, as remonumented by Glenn Richard in 1974.

Set a Standard Jackson County Monument to replace the iron, 5/19/1997.

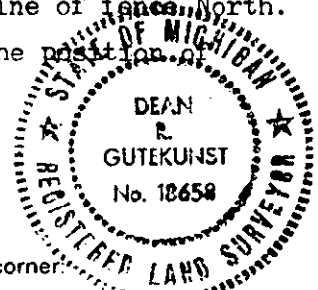

**Description of monument for corner and accessories established to perpetuate locating the position of the corner:**

J-13 T4S, R1E Corner is a 4" diameter X 30" Cast Iron Harrison monument with a brass cap stamped LS 18658, which is a standard monument for Jackson County.

- S 75°W 9" Oak 120.85' Pole barn spike and washer on North side.  
 S 30°E 18" Locust 36.77' Pole barn spike and washer on Southwest side.  
 N 75°E Top of metal culvert at West end 125.88'  
 North Found rod in fence line 79.90'  
 North Capped iron LS# 33970 33.07'  
 East Iron in monument box 8.75' (North  $\frac{1}{4}$  Post of Section 2, T5S, R1E)  
 North Steel post and survey marker sign attached 33.3'  
 Monument box set by Jackson County Road Commission.

igned by Dean R. Gutekunst Date July 1, 1997

urveyor's Michigan License No. 18658