

JACKSON COUNTY
APPROVED LAND CORNER
P.A. 343 of 1996
ACTING
Chairman *[Signature]*
Timothy C. VAN GIESSEN
Date 08-13-97

NORTHEAST CORNER, SECTION 6
 LIBERTY TOWNSHIP

LAND CORNER RECORDATION CERTIFICATE
 Filing Requirement of Act 74, Mich. P.A. 1970

#2044421
 Liber 1549 Page 141
 Page 1 of 2
 Jackson Co., MI
 Recorded
 08/15/97 11:00A
 Mindy Reilly
 Register of Deeds

For corners in
JACKSON
 (County)


	Located In:	Corner Code #
1. Public Land Survey	T <u>4 S</u> R <u>1 W</u>	<u>C-1</u>
	T _____ R _____	_____
	T _____ R _____	_____
	T _____ R _____	_____
2. Property Controlling in Section	S _____ T _____ R _____	_____
	S _____ T _____ R _____	_____
3. Miscellaneous Property in Sec.	S _____ T _____ R _____	_____
	S _____ T _____ R _____	_____

SURVEY & MONUMENTATION

APR 07 1998

SECTION
Register of Deeds Stamp & File Number

4. Lot No. _____, Recorded Plat _____
 5. Private Claims _____

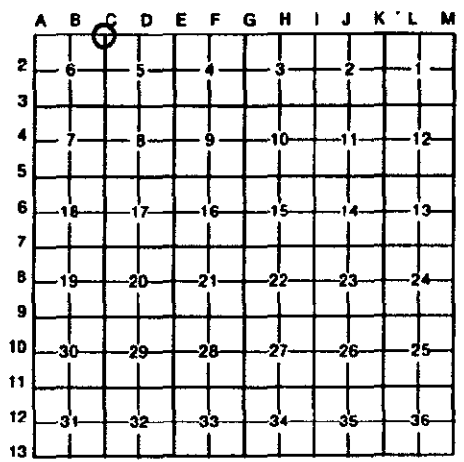

DEAN R. GUTEKUNST, in a field survey on October 16, 19 95

to hereby certify that under requirements of P.A. 74, Michigan P.A. of 1970, the corner points mentioned in lines 1 and 2 above were in conformance with regulations and rules therefore as required in the current manual of survey instructions of the United States Department of the Interior, Bureau of Land Management or by a decree of a Court of Law and/or that the corner points mentioned in lines 3, 4 and 5 above were in conformance with the rules of the Michigan Board of Land Surveyors or by a Decree of a Court of Law; established, re-established, monumented, re-monumented, recovered, found as expressed below:

NOTE: Not more than 4 corners, all in the same town and range, may be recorded on this certificate.

A. Description of original monument and accessories and/or subsequent restoration:

Original Government Post set by Hervey Parke, Deputy Surveyor, 1825.
 W. Oak 9" S 67 W 30 links (19.80') 80.38 Intersect North boundary 42 links
 W. Oak 7" S 32 E 23 links (15.18') (27.72') East of post. Set post corner Section 5 & 6.

Perpetuation by H. F. Bean, no date.
 W. Oak 24" N 7 1/4 W 47 links (31.02') Set Stone 2' long and witnesses standing.
 Hickory 12" S 48 1/2 W 59 links (38.94')

Continued on back,

Description of corner evidence found and/or method applied in restoring or reestablishing corner:

Found capped iron, #7863, set in 1972, 0.67' North of center line of stone.

Corner is 2' ± North of center line of Kimmel Road (gravel) and in line of occupation South.

Accepted iron as a careful and faithful perpetuation of the position of the amended corner.

Set a Standard Jackson County Monument to replace the iron.



Description of monument for corner and accessories established to perpetuate locating the position of the corner:

C-1 T4S, R1W Corner is a 4" diameter X 36" concrete monument with a 1/2" X 36" steel rod and an aluminum cap stamped LS 18658, which is a standard monument for Jackson County.

*	N 50° W	24" Hickory	44.55'	60d nail on Northeast side.
**	N 60° E	36" Oak	60.00'	60d nail on Southeast side.
***	S 15° W	20" W. Oak	28.40'	60d nail on East side.
****	South	23" Hickory	35.93'	60d nail on East side
	S 60° W	9" Oak	84.41'	40d nail and washer on Northwest side.
	N 70° W	30" Oak	86.96'	60d nail on South side.
	West	Southeast corner of Section 31, Town 3 South, Range 1 West		27.54' (concrete monument)

igned by Dean R. Gutekunst
 Surveyor's Michigan License No. 18658

Date August 1, 1997