

JACKSON COUNTY
APPROVED LAND CORNER SE CORNER SECTION 31, LIBERTY TOWNSHIP
P.A. 345 of 1990

Chairman Dean Falkland
 Date Dec. 20, 1994

REMONUMENTATION
LAND CORNER RECORDATION CERTIFICATE
 Filing Requirement of Act 74, Mich. P.A. 1970

LIBER **1451** PAGE **417**

For corners in

| _____ JACKSON _____ (County) | Located In: | Corner Code # |
|---------------------------------------|-------------------------|---------------|
| 1. Public Land Survey | T 4S R 1W | C-13, |
| | T _____ R _____ | _____ |
| | T _____ R _____ | _____ |
| | T _____ R _____ | _____ |
| 2. Property Controlling in Section | S _____ T _____ R _____ | _____ |
| | S _____ T _____ R _____ | _____ |
| 3. Miscellaneous Property in Sec. | S _____ T _____ R _____ | _____ |
| | S _____ T _____ R _____ | _____ |

STATE OF MICHIGAN
 JACKSON COUNTY
 RECORDED

30 DEC 94 3:29 P.M.

GERALD J. McDEVITT
 REGISTER OF DEEDS

Register of Deeds Stamp & File Number

4. Lot No. _____, Recorded Plat _____
 5. Private Claims _____

| | A | B | C | D | E | F | G | H | I | J | K | L | M |
|----|----|----|----|----|----|----|---|---|---|---|---|---|---|
| 2 | 6 | 5 | 4 | 3 | 2 | 1 | | | | | | | |
| 3 | | | | | | | | | | | | | |
| 4 | 7 | 8 | 9 | 10 | 11 | 12 | | | | | | | |
| 5 | | | | | | | | | | | | | |
| 6 | 18 | 17 | 16 | 15 | 14 | 13 | | | | | | | |
| 7 | | | | | | | | | | | | | |
| 8 | 19 | 20 | 21 | 22 | 23 | 24 | | | | | | | |
| 9 | | | | | | | | | | | | | |
| 10 | 30 | 29 | 28 | 27 | 26 | 25 | | | | | | | |
| 11 | | | | | | | | | | | | | |
| 12 | 31 | 32 | 33 | 34 | 35 | 36 | | | | | | | |
| 13 | | | | | | | | | | | | | |

I, John E. Maxson in a field survey on 4 November, 1994, do hereby certify that under requirements of P.A. 74, Michigan P.A. of 1970, the corner points mentioned in lines 1 and 2 above were in conformance with regulations and rules therefore as required in the current manual of survey instructions of the United States Department of the Interior, Bureau of Land Management or by a decree of a Court of Law and/or that the corner points mentioned in lines 3, 4 and 5 above were in conformance with the rules of the Michigan Board of Land Surveyors or by a Decree of a Court of Law; established, re-established, monumented, re-monumented, recovered, found as expressed below:

NOTE: Not more than 4 corners, all in the same town and range, may be recorded on this certificate.

A. Description of original monument and accessories and/or subsequent restoration:

POST SET IN ORIGINAL GOVERNMENT SURVEY BY JOSEPH WAMPLER 1823
 14"W.Oak, N49.5W, 47.5 lks (31.35 ft) - 17"W.Oak, N24E, 70.5 lks (46.53 ft)
 Corner to South, 260 lks (171.60 ft) East
 1922 WITNESSES CALL FOR 1 1/2" X 4" PIPE ON SOUTH SIDE OF STONE CORNER
 FROM LAND CORNER RECORDATION CERTIFICATE (LCRC) IN LIBER 2, PAGE 217
 22"Maple, N06E, 24.5' - 14"Maple, N43W, 34.8' - 12"Maple, S61.5W, 38.6',
 10"Maple, S70E, 62.75'

RICHARD E. GUTEKUNST, RLS#7863 RECORDED CORNER IN APRIL 1973, (LIBER 2, PAGE 217) AS EXISTING IRON PIPE
 22"Maple, S72E, 63.41' - 8"Hickory, S37W, 24.65' - 27"Maple, N45W, 35.55' -
 27"Maple, N05E, 25.15' - 14"Oak, S63W, 52.00' - 2.5"Post, N02E, 30.73'

B. Description of corner evidence found and/or method applied in restoring or reestablishing corner:


FOUND 1 1/2" IRON PIPE PER LCRC (LIBER 2, PAGE 217) OVER STONE AND ACCEPTED AS A CAREFUL AND FAITHFUL PERPETUATION OF THE POSITION OF THE ORIGINAL CORNER. REPLACED WITH STANDARD 4" CONCRETE MONUMENT AND CAP

**SURVEY &
 REMONUMENTATION**
 MAY 08 1995
COMMISSION

\$ 2.00 REMONUMENTATION
 \$ 7.00 CORNER REMONUMENTATION

C. Description of monument for corner and accessories established to perpetuate locating the position of the corner:

SET STANDARD 4" DIAMETER CONCRETE MONUMENT WITH JACKSON COUNTY REMONUMENTATION CAP STAMPED LS#27454
 S45E 19.30' NAIL IN 38"CHERRY
 S35W 17.42' NAIL IN 12"OAK
 S40W 24.72' NAIL IN 12"HICKORY
 NORTH 25.00' NAIL IN 40"OAK

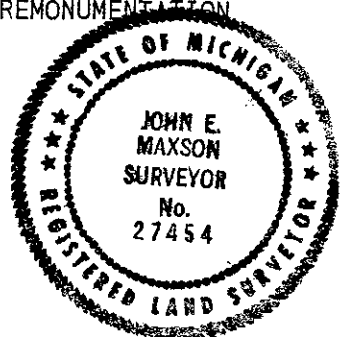

Signed by [Signature]
 Surveyor's Michigan License No. 27454

Date 8 December, 1994