

Chairman Don G. Gulderson  
Date Dec. 20, 1994

REMONUMENTATION

LIBER **1451** PAGE **418**

**LAND CORNER RECORDATION CERTIFICATE**  
Filing Requirement of Act 74, Mich. P.A. 1970

For corners in

_____ JACKSON _____ (County)	Located In:	Corner Code #
1. Public Land Survey	T <u>45</u> R <u>11W</u>	<u>D-13.</u>
	T _____ R _____	_____
	T _____ R _____	_____
	T _____ R _____	_____
2. Property Controlling in Section	S _____ T _____ R _____	_____
	S _____ T _____ R _____	_____
3. Miscellaneous Property in Sec.	S _____ T _____ R _____	_____
	S _____ T _____ R _____	_____
4. Lot No. _____, Recorded Plat _____		
5. Private Claims _____		

STATE OF MICHIGAN  
JACKSON COUNTY  
RECORDED

30 DEC 94 3:29 P.M.

GERALD J. McDEVITT  
REGISTER OF DEEDS

Register of Deeds Stamp & File Number

	A	B	C	D	E	F	G	H	I	J	K	L	M
2	6		5		4		3		2		1		
3													
4	7		8		9		10		11		12		
5													
6	18		17		16		15		14		13		
7													
8	19		20		21		22		23		24		
9													
10	30		29		28		27		26		25		
11													
12	31		32		33		34		35		36		
13													

I, John E. Maxson in a field survey on 4 November, 1994, do hereby certify that under requirements of P.A. 74, Michigan P.A. of 1970, the corner points mentioned in lines 1 and 2 above were in conformance with regulations and rules therefore as required in the current manual of survey instructions of the United States Department of the Interior, Bureau of Land Management or by a decree of a Court of Law and/or that the corner points mentioned in lines 3, 4 and 5 above were in conformance with the rules of the Michigan Board of Land Surveyors or by a Decree of a Court of Law, established, re-established, monumented, re-monumented, recovered, found as expressed below:

**NOTE: Not more than 4 corners, all in the same town and range, may be recorded on this certificate.**

A. Description of original monument and accessories and/or subsequent restoration:

POST SET IN ORIGINAL GOVERNMENT SURVEY BY JOSEPH WAMPLER 1823  
30" E.Oak, N76W, 68 lks (44.88 ft), 13" B.Oak, N11E - 39 lks (25.74 ft)  
1922 WITNESSES CALL FOR IRON AT SIDE OF STONE IN LINE WITH FENCE LINE NORTH FROM LAND CORNER RECORDATION CERTIFICATE (LCRC) IN LIBER 2, PAGE 215  
RICHARD E. GUTEKUNST, RLS#7863 RECORDED CORNER IN 1973 (LIBER 2, PAGE 215)  
AS PINCHED TOP IRON ON EAST SIDE OF STONE  
10" Hickory, S62E, 48.25' - 10" Oak, N71E, 20.95' - 8" Ash, N31W, 33.15' - 4" Hickory, S62W, 31.60'

B. Description of corner evidence found and/or method applied in restoring or reestablishing corner:


FOUND 1 1/2" IRON PIPE PER LCRC (LIBER 2, PAGE 215) OVER STONE AND ACCEPTED AS A CAREFUL AND FAITHFUL PERPETUATION OF THE POSITION OF THE ORIGINAL CORNER. REPLACED WITH STANDARD 4" CONCRETE MONUMENT AND CAP

**SURVEY &  
REMONUMENTATION**  
  
MAY 08 1995  
  
**COMMISSION**

\$ 2.00 REMONUMENTATION  
\$ 7.00 CORNER REMONUMENTATION

C. Description of monument for corner and accessories established to perpetuate locating the position of the corner:

SET STANDARD 4" DIAMETER CONCRETE MONUMENT WITH JACKSON COUNTY REMONUMENTATION CAP STAMPED LS#27454  
N20E 20.09' NAIL IN 12" WALNUT  
N28W 33.25' NAIL IN 18" WALNUT  
S12E 10.77' NAIL IN 10" WALNUT  
S28E 11.77' NAIL IN 14" WALNUT  
EAST 137.23' CAPPED 5/8 IRON AT D-1, T5S-R1W

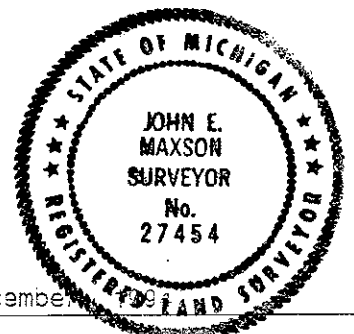

Signed by [Signature]  
Surveyor's Michigan License No. 27454

Date 8 December