

**JACKSON COUNTY
APPROVED LAND CORNER
P.A. 345 of 1990**

S 1/4 CORNER SECTION 33, LIBERTY TOWNSHIP

Chairman Dean R. Huttker
Date Dec 20, 1994

REMONUMENTATION

LAND CORNER RECORDATION CERTIFICATE
Filing Requirement of Act 74, Mich. P.A. 1970

LIBER 1451 PAGE 420

STATE OF MICHIGAN
JACKSON COUNTY
RECORDED

30 DEC 94 3:30 P.M.

GERALD J. McDEVITT
REGISTER OF DEEDS

Register of Deeds Stamp & File Number

For corners in

	JACKSON (County)	Located In:	Corner Code #
1. Public Land Survey	T 58 R 1W		E-13.
	T	R	
	T	R	
	T	R	
2. Property Controlling in Section	S T R		
	S T R		
3. Miscellaneous Property in Sec.	S T R		
	S T R		
4. Lot No. _____, Recorded Plat _____			
5. Private Claims _____			

	A	B	C	D	E	F	G	H	I	J	K	L	M
2	6	5	4	3	2	1							
3													
4	7	8	9	10	11	12							
5													
6	18	17	16	15	14	13							
7													
8	19	20	21	22	23	24							
9													
10	30	29	28	27	26	25							
11													
12	31	32	33	34	35	36							
13													

I, John E. Maxson in a field survey on 4 November, 1994, do hereby certify that under requirements of P.A. 74, Michigan P.A. of 1970, the corner points mentioned in lines 1 and 2 above were in conformance with regulations and rules therefore as required in the current manual of survey instructions of the United States Department of the Interior, Bureau of Land Management or by a decree of a Court of Law and/or that the corner points mentioned in lines 3, 4 and 5 above were in conformance with the rules of the Michigan Board of Land Surveyors or by a Decree of a Court of Law; established, re-established, monumented, re-monumented, recovered, found as expressed below:

NOTE: Not more than 4 corners, all in the same town and range, may be recorded on this certificate.

A. Description of original monument and accessories and/or subsequent restoration:
POST SET IN ORIGINAL GOVERNMENT SURVEY BY JOSEPH WAMPLER 1823
24"W.Oak, N42.5W, 111 lks (73.25 ft) - 28"W.Oak, N18E, 158 lks (104.28 ft)
CORNER SHOWN ON THE PLAT OF "MIRROR LAKE NO. 1"
NO WITNESSES GIVEN

B. Description of corner evidence found and/or method applied in restoring or reestablishing corner:
CORNER FILLS IN AREA OF ABOUT 15 FEET OF FILL OVER SWAMP. RESET THIS CORNER FROM THE RECORDED PLAT. THE POSITION FITS OCCUPATION AND THE PROPORTIONATE MEASURE EAST AND WEST. ACCEPTED AS A CAREFUL AND FAITHFUL PERPETUATION OF THE POSITION OF THE ORIGINAL CORNER.
REPLACED WITH STANDARD 4" CONCRETE MONUMENT AND CAP


**SURVEY &
REMONUMENTATION**

MAY 08 1995

COMMISSION

\$ 2.00 REMONUMENTATION
\$ 7.00 CORNER REMONUMENTATION

C. Description of monument for corner and accessories established to perpetuate locating the position of the corner:
SET STANDARD 4" DIAMETER CONCRETE MONUMENT WITH JACKSON COUNTY REMONUMENTATION CAP STAMPED LS#27454
N55E 51.53' NAIL IN 8" ELM
S31E 40.71' NAIL IN 40" OAK
S12W 41.88' NAIL IN 8" PINE
N24W 51.35' NAIL IN 12" ELM
EAST 151.67' CAPPED 5/8 IRON AT E-1, T5S-R1W

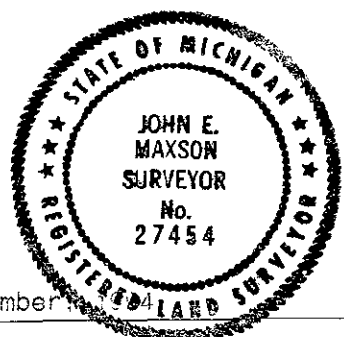

Signed by John E. Maxson
Surveyor's Michigan License No. 27454

Date 3 December