

Chairman Dean Stutzman
 Date Dec. 20, 1994

LAND CORNER RECORDATION CERTIFICATE
 Filing Requirement of Act 74, Mich. P.A. 1970

STATE OF MICHIGAN
 JACKSON COUNTY
 RECORDED

30 DEC 94 3:30 P.M.

GERALD J. McDEVITT
 REGISTER OF DEEDS

Register of Deeds Stamp & File Number

For corners in
JACKSON
 (County)

Located In: 4S 1W Corner Code # H-13,

1. Public Land Survey	T	R	
	T	R	
	T	R	
	T	R	
2. Property Controlling in Section	S	T	R
	S	T	R
3. Miscellaneous Property in Sec.	S	T	R
	S	T	R

4. Lot No. _____, Recorded Plat _____
 5. Private Claims _____

	A	B	C	D	E	F	G	H	I	J	K	L	M
2	6		5		4		3		2		1		
3													
4	7		8		9		10		11		12		
5													
6	18		17		16		15		14		13		
7													
8	19		20		21		22		23		24		
9													
10	30		29		28		27		26		25		
11													
12	31		32		33		34		35		36		
13													

I, John E. Maxson, in a field survey on 4 November, 1994, do hereby certify that under requirements of P.A. 74, Michigan P.A. of 1970, the corner points mentioned in lines 1 and 2 above were in conformance with regulations and rules therefore as required in the current manual of survey instructions of the United States Department of the Interior, Bureau of Land Management or by a decree of a Court of Law and/or that the corner points mentioned in lines 3, 4 and 5 above were in conformance with the rules of the Michigan Board of Land Surveyors or by a Decree of a Court of Law; established, re-established, monumented, re-monumented, recovered, found as expressed below:

NOTE: Not more than 4 corners, all in the same town and range, may be recorded on this certificate.

A. Description of original monument and accessories and/or subsequent restoration:
 POST SET IN ORIGINAL GOVERNMENT SURVEY BY JOSEPH WAMPLER 1823
 12" B.Oak, N86W, 1195 lks (78.37 ft) - 26" W.Oak, N39.5E, 25.25 lks (16.66)
 1885, HILLDALE COUNTY RECCRD #988 CALLS FOR STONE SET FOR CORNER H-1, T5S-R1W, AT A MIDPOINT BETWEEN NW CORNER SECTION 3 BEING AT 262 LKS EAST OF STONE AT SW CORNER AND NE CORNER SECTION 3 BEING AT 149 LKS EAST OF STONE AT SE CORNER SECTION 34
 1986, BRUCE LEONE PS#22409 SET HARRISON MONUMENT OVER STONE AT CONRER H-1, T5S-R1W ON LAND CORNER REMONUMENTATION CERTIFICATE IN LIBER 556, PAGE 180

B. Description of corner evidence found and/or method applied in restoring or reestablishing corner:
 FOUND NO EVIDENCE OF THIS CORNER. RESET FROM CORNER H-1, T5S-R1W, AT MEAN FALLING OF 203.5 LKS AS A CAREFUL AND FAITHFUL REESTABLISHMENT OF THE POSITION OF THE ORIGINAL CORNER


SURVEY & REMONUMENTATION

MAY 08 1995

COMMISSION

\$ 2.00 REMONUMENTATION
 \$ 7.00 CORNER REMONUMENTATION

C. Description of monument for corner and accessories established to perpetuate locating the position of the corner:
 SET STANDARD 4" DIAMETER CONCRETE MONUMENT WITH JACKSON COUNTY REMONUMENTATION
 CAP STAMPED LS#27454
 S31E 24.71' NAIL IN 12" MAPLE
 N35E 39.52' NAIL IN FENCE CORNER POST
 N40W 47.14' NAIL IN 4" CEDAR
 S57E 59.37' NAIL IN 14" OAK
 EAST 134.31' HARRISON MONUMENT AT H-1, T5S-R1W

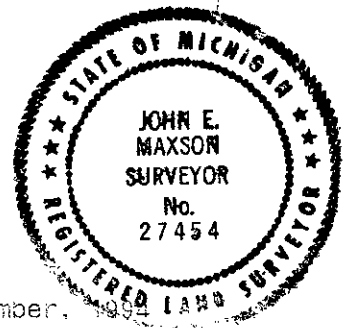

Signed by John E. Maxson
 Surveyor's Michigan License No. 27454

Date 8 December, 1994