

Chairman Dean R. Hatten

REMONUMENTATION

Date Dec. 20, 1994

LAND CORNER RECORDATION CERTIFICATE
Filing Requirement of Act 74, Mich. P.A. 1970

For corners in

	Located In:	Corner Code #
JACKSON (County)		
1. Public Land Survey	T 4S R 1W	K-13,
	T R	
	T R	
	T R	
2. Property Controlling in Section	S T R	
	S T R	
3. Miscellaneous Property in Sec.	S T R	
	S T R	

STATE OF MICHIGAN
 JACKSON COUNTY
 RECORDED

30 DEC 94 3:30 P.M.

GERALD J. McDEVITT
 REGISTER OF DEEDS

Register of Deeds Stamp & File Number

4. Lot No. _____, Recorded Plat _____
 5. Private Claims _____

	A	B	C	D	E	F	G	H	I	J	K	L	M
2	6		5		4		3		2				
3													
4	7		8		9		10		11		12		
5													
6	13		17		16		15		14		13		
7													
8	19		20		21		22		23		24		
9													
10	30		29		28		27		26		25		
11													
12	31		32		33		34		35		36		
13													

I, John E. Maxson in a field survey on 4 November, 1994 do hereby certify that under requirements of P.A. 74, Michigan P.A. of 1970, the corner points mentioned in lines 1 and 2 above were in conformance with regulations and rules therefore as required in the current manual of survey instructions of the United States Department of the Interior, Bureau of Land Management or by a decree of a Court of Law and/or that the corner points mentioned in lines 3, 4 and 5 above were in conformance with the rules of the Michigan Board of Land Surveyors or by a Decree of a Court of Law, established, re-established, monumented, re-monumented, recovered, found as expressed below:

NOTE: Not more than 4 corners, all in the same town and range, may be recorded on this certificate.

A. Description of original monument and accessories and/or subsequent restoration:

POST SET IN ORIGINAL GOVERNMENT SURVEY BY JOSEPH WAMPLER 1823.
 15" Aspen, N10.5E, 27 lks (17.82 ft) - 16"W.Oak, N50W, 158 lks (104.28 ft)
 Corner to South, 115 lks (75.92 ft) East

DOUGLAS W. HOOTH, RLS#7966 RECORDED CORNER IN JUNE 1977 (LIBER 3, PAGE 61)
 AS 1/2" COPPER CLAD ROD OVER STONE
 RR Tie Post, North, 33.73' - 11"Hickory, N55W, 51.29' - 12"Oak, S35E, 35.14 -
 25"Oak, S58W, 40.91

B. Description of corner evidence found and/or method applied in restoring or reestablishing corner:

FOUND IRON AS RECORDED OVER STONE AND ACCEPTED AS A CAREFUL AND FAITHFUL PERPETUATION OF THE POSITION OF THE ORIGINAL CORNER.
 REPLACED WITH STANDARD 4" CONCRETE MONUMENT AND CAP

**SURVEY &
 REMONUMENTATION**


MAY 08 1995

COMMISSION

\$ 2.00 REMONUMENTATION
 \$ 7.00 CORNER REMONUMENTATION

C. Description of monument for corner and accessories established to perpetuate locating the position of the corner:

SET STANDARD 4" DIAMETER CONCRETE MONUMENT WITH JACKSON COUNTY REMONUMENTATION
 CAP STAMPED LS#27454
 NORTH 33.65' NAIL IN RR.POST
 N55W 51.10' NAIL IN 11"HICKORY
 S55W 33.30' NAIL IN 32"DBL.OAK
 N33W 42.32' NAIL IN 20"OAK
 S75W 68.68' NAIL IN 16"OAK

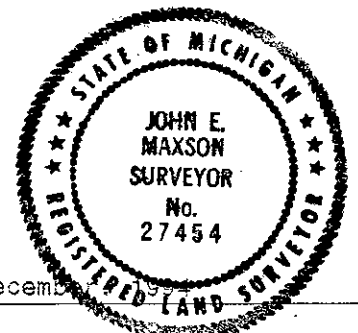

Signed by John E. Maxson
 Surveyor's Michigan License No. 27454

Date 8 December