

**JACKSON COUNTY  
APPROVED LAND CORNER  
P.A. 345 of 1990**

Acting Chairman Ren Enger

Date 12-30-94

**SOUTH 1/4 POST, SECTION 5  
NAPOLEON TOWNSHIP**

LIBER **1482** PAGE **632**  
STATE OF MICHIGAN  
JACKSON COUNTY  
RECORDED

**LAND CORNER RECORDATION CERTIFICATE  
Filing Requirement of Act 74, Mich. P.A. 1970**

For corners in  
**JACKSON**  
(County)

Located In: Corner Code #

17 AUG 95 9:47 A.M.

GERALD J. McDEVITT  
REGISTER OF DEEDS

- |                                    |                           |            |
|------------------------------------|---------------------------|------------|
| 1. Public Land Survey              | T <u>4</u> S R <u>2</u> E | <u>D-3</u> |
|                                    | T _____ R _____           | _____      |
|                                    | T _____ R _____           | _____      |
|                                    | T _____ R _____           | _____      |
| 2. Property Controlling in Section | S _____ T _____ R _____   | _____      |
|                                    | S _____ T _____ R _____   | _____      |
| 3. Miscellaneous Property in Sec.  | S _____ T _____ R _____   | _____      |
|                                    | S _____ T _____ R _____   | _____      |


Register of Deeds Stamp & File Number

4. Lot No. \_\_\_\_\_, Recorded Plat \_\_\_\_\_  
5. Private Claims \_\_\_\_\_

I, Dean R. Gutekunst, in a field survey on December 21, 19 94,

do hereby certify that under requirements of P.A. 74, Michigan P.A. of 1970, the corner points mentioned in lines 1 and 2 above were in conformance with regulations and rules therefore as required in the current manual of survey instructions of the United States Department of the Interior, Bureau of Land Management or by a decree of a Court of Law and/or that the corner points mentioned in lines 3, 4 and 5 above were in conformance with the rules of the Michigan Board of Land Surveyors or by a Decree of a Court of Law: established, re-established, monumented, re-monumented, recovered, found as expressed below:

NOTE: Not more than 4 corners, all in the same town and range, may be recorded on this certificate.

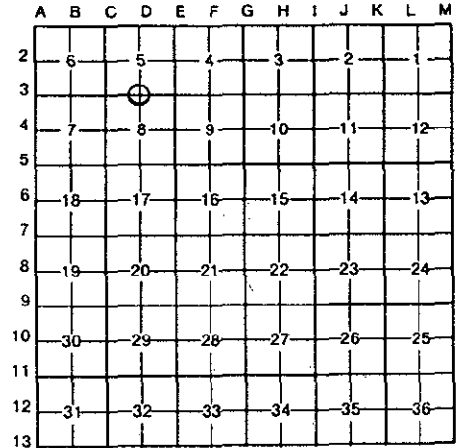

A. Description of original monument and accessories and/or subsequent restoration:

Original Government Post set by Hervey Parke, Deputy Surveyor, 1824

Y. Oak 26" N 36 1/2 E 46 links (30.36')  
Y. Oak 18" S 85 W 25 links (16.50')

Perpetuation by John Holcraft, date unknown,

(\* Maple 10" N 89 E 22 3/4 links (15.015')  
(\*\*) Hickory 9" S 81 W 57 2/3 links (38.06')

fireclay (3" diameter x 24" long)  
Established on transit line at  
average distance 39.86

Perpetuation by F.C. Riley, found fireclay (1929)

(\*\*\*) Maple 20" N 15 W 109.35'  
Maple 24" N 10 E 90.5'

1 1/2 South of fences East and West

(Continued on back)

B. Description of corner evidence found and/or method applied in restoring or reestablishing corner:

Found fireclay, and iron, 12" below gravel surface of Wolf Lake Road  
Approximately 5 1/2' east of center line of gravel, Wolf Lake Road  
In line with Hedge Rows East and West

Accepted fireclay as a careful and faithful perpetuation of the position of the ~~original~~ corner as monumented by Holcraft. Replaced fireclay with a Standard Jackson County Monument and left fireclay buried on north side of Monument. Monument is 6" below gravel surface.

C. Description of monument for corner and accessories established to perpetuate locating the position of the corner:

D-3 T4S, R2E Corner is a 4" diameter x 36" concrete monument with a 1/2" x 36" steel rod and an aluminum cap stamped LS 18658, which is the standard monument for Jackson County.

N 5° E	20" Maple	115.3'	Found 60d nail on West side
N 20° W	30" Maple	110.52'	Found 60d nail on East side
East	7" Walnut	37.72'	Found 60d nail on North side
S 10° E	Utility Pole	94.8'	Nail and cap on West side
N 60° E	Railroad tie post	18.80'	Nail and cap on Northwest corner



Signed by Dean R. Gutekunst Date December 29, 1994  
Surveyor's Michigan License No. 18658

## A. Continued

Perpetuation by R. E. Gutekunst, R.L.S. #7863, October 30, 1965

Found fireclay, 12" below gravel surface,  
7' east of center line of road and in line with  
fence east. Set iron on north side.

(*)	N 88 <sup>0</sup> E	24" Maple	15.33'	stump May 1990
(***)	N 7 <sup>0</sup> E	24" Maple	91.42'	stump May 1990
(**)	S 79 <sup>0</sup> W	30" Hickory	38.00'	
	S 17 <sup>0</sup> E	12" Cherry	66.35'	

Perpetuation by Dean R. Gutekunst, R.L.S. #18658, May 26, 1990

Found fireclay and iron

East		6" Walnut	37.85'
N 5 <sup>0</sup> E		20" Maple	115.15'
N 20 <sup>0</sup> W		30" Maple	110.3'