

**JACKSON COUNTY
APPROVED LAND CORNER
P.A. 345 of 1990**

Acting Chairman Ren Enger

**SOUTH 1/4 POST, SECTION 10
NORVELL TOWNSHIP**

LIBER 1482 PAGE 626

LAND CORNER RECORDATION CERTIFICATE

Date 12-30-94

Filing Requirement of Act 74, Mich. P.A. 1970

For corners in

JACKSON
(County)

Located In:

Corner Code #

- | | | |
|---------------------------------------|---------------------------|------------|
| 1. Public Land Survey | T <u>4</u> S R <u>2</u> E | <u>H-5</u> |
| | T _____ R _____ | _____ |
| | T _____ R _____ | _____ |
| | T _____ R _____ | _____ |
| 2. Property Controlling in Section | S _____ T _____ R _____ | _____ |
| | S _____ T _____ R _____ | _____ |
| 3. Miscellaneous Property in Sec. | S _____ T _____ R _____ | _____ |
| | S _____ T _____ R _____ | _____ |
| 4. Lot No. _____, Recorded Plat _____ | | |
| 5. Private Claims _____ | | |


STATE OF MICHIGAN
JACKSON COUNTY
RECORDED

17 AUG 95 9:47 A.M.

GERALD J. McDEVITT
REGISTER OF DEEDS

Register of Deeds Stamp & File Number

I, Dean R. Gutekunst, in a field survey on September 21, 19 94, do hereby certify that under requirements of P.A. 74, Michigan P.A. of 1970, the corner points mentioned in lines 1 and 2 above were in conformance with regulations and rules therefore as required in the current manual of survey instructions of the United States Department of the Interior, Bureau of Land Management or by a decree of a Court of Law and/or that the corner points mentioned in lines 3, 4 and 5 above were in conformance with the rules of the Michigan Board of Land Surveyors or by a Decree of a Court of Law; established, re-established, monumented, re-monumented, recovered, found as expressed below:

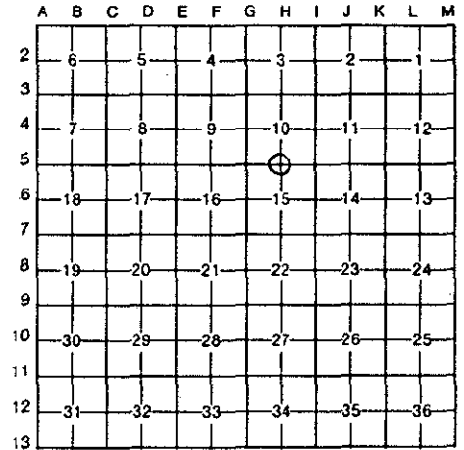

NOTE: Not more than 4 corners, all in the same town and range, may be recorded on this certificate.

A. Description of original monument and accessories and/or subsequent restoration:

Original Government Post set by Hervey Parke, Deputy Surveyor, Feb, 1824

- W. Oak 28" N 36 E 32 links (21.12')
- W. Oak 14" N 22 W 36 links (23.76')

(Continued by back)

B. Description of corner evidence found and/or method applied in restoring or reestablishing corner:

Found fireclay, at surface gravel, Arnold Road, near south edge from 1968 witnesses. Broken brick was around and under fireclay.

Accepted fireclay as a careful and faithful perpetuation of the position of the original corner as remonumented by LaRue, in 1884. Replaced fireclay with a Standard Jackson County Monument and left fireclay on north side of monument and with brick under and around Monument. Monument is 4" below gravel surface of Arnold Road.

C. Description of monument for corner and accessories established to perpetuate locating the position of the corner:

H-5 T4S, R2E Corner is a 4" diameter x 36" concrete monument with a 1/2" x 36" steel rod and an aluminum cap stamped LS 18658, which is the standard monument for Jackson County

- N 55° W 36" Oak 58.32' Nail and cap on southwest side
- N 30° W 27" Oak 35.47' Nail and cap on east side
- N 25° E 20" Oak 28.28' Nail and cap on east side
- N 65° E 24" Oak 82.00' Nail and cap on south side
- S 55° E 18" Walnut 54.27' Nail and cap on north side
- S 40° W 8" Oak 33.55' Nail and cap on west side
- North Angle iron post 34.65' South corner



Signed by Dean R. Gutekunst Date December 29, 1994
Surveyor's Michigan License No. 18658

A. Continued

Perpetuation by B.F. LaRue, Nov., 1884
Set a fireclay post (3" diameter x 24" long)

Found traces of both witnesses and stake agreeing. All rather uncertain but they agree with each other and with the fence and an old ditch. I took stake as correct.

W. Oak	12"	N 16½ W	35½ links (23.43')	broken brick
W. Oak	14"	S 73 W	143 links (94.38')	stump, Jan 1968

Perpetuation by Richard E. Gutekunst, R.L.S. #7863, Jan. 31, 1968
found fireclay, set irons on east and west side of fireclay

N 55 W	30" Oak	58.32'	
N 25 E	12" Oak	28.28'	
N 30 W	24" Oak	35.47'	
North	Angle iron corner post	34.52'	South corner of post