

ACTING Chairman
 TIMOTHY E. VAN GIESEN
 Date 12-11-96

LAND CORNER RECORDATION CERTIFICATE
 Filing Requirement of Act 74, Mich. P.A. 1970

#2022471
 Liber 1533 Page 351
 Page 1 of 2
 Jackson Co., MI
 Recorded
 12/12/96 01:04P
 Jerry McDevitt
 Register of Deeds

For corners in

JACKSON

(County)

Located In:

Corner Code ##

1. Public Land Survey	T 4 S R 2 E	I-12
	T _____ R _____	_____
	T _____ R _____	_____
	T _____ R _____	_____
2. Property Controlling in Section	S _____ T _____ R _____	_____
	S _____ T _____ R _____	_____
3. Miscellaneous Property in Sec.	S _____ T _____ R _____	_____
	S _____ T _____ R _____	_____

Register of Deeds Stamp & File Number

4. Lot No. _____, Recorded Plat _____
 5. Private Claims _____

	A	B	C	D	E	F	G	H	I	J	K	L	M
2	6	5	4	3	2	1							
3													
4	7	8	9	10	11	12							
5													
6	18	17	16	15	14	13							
7													
8	19	20	21	22	23	24							
9													
10	30	29	28	27	26	25							
11													
12	31	32	33	34	35	36							
13													

I, DEAN R. GUTEKUNST, in a field survey on November 13, 1996, do hereby certify that under requirements of P.A. 74, Michigan P.A. of 1970, the corner points mentioned in lines 1 and 2 above were in conformance with regulations and rules therefore as required in the current manual of survey instructions of the United States Department of the Interior, Bureau of Land Management or by a decree of a Court of Law and/or that the corner points mentioned in lines 3, 4 and 5 above were in conformance with the rules of the Michigan Board of Land Surveyors or by a Decree of a Court of Law; established, re-established, monumented, re-monumented, recovered, found as expressed below:

NOTE: Not more than 4 corners, all in the same town and range, may be recorded on this certificate.

A. Description of original monument and accessories and/or subsequent restoration:

Original Government Post set by Hervey Parke, Deputy Surveyor, February 1824.

- W. Oak 20" S 24 E 29 links (19.14')
- B. Ash 5" N 75 W 1 1/2 links (0.99')
- Perpetuation by B. F. LaRue, November 26, 1884
- W. Oak 4" N 18 1/4 W 35 1/2 links (23.43')
- * Hickory 10" N 43 1/2 W 4 links (2.64')
- B. Ash 14" N 77 W 2 links (1.32')

Found Ash where Ash was called for but it had no blaze. Where Oak 20 was called for found remains Oak 10 Could not find stake as it would be among roots of Ash in wet black soil. As these trees agree with each other and with fences I concluded they were sprouts from original trees.

Continued on back,


B. Description of corner evidence found and/or method applied in restoring or reestablishing corner:

Found 1.7' of bottom of FIRECLAY from above information. Also found broken 11" of a second fireclay below. There may also be more fireclay below new monument in water.

Old fence is mostly down, but some still exists on trees.

Accepted FIRECLAY, as a careful and faithful perpetuation of the position of the original corner, as remonumented by LaRue in 1884.

Set a Standard Jackson County Monument to replace fireclay and left the fireclay beside the monument.

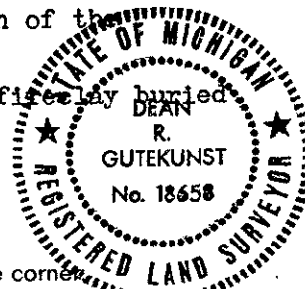

C. Description of monument for corner and accessories established to perpetuate locating the position of the corner:

I-12 T4S, R2E Corner is a 4" diameter X 36" concrete monument with a 1/2" X 36" steel rod and an aluminum cap stamped LS 18658, which is the standard monument for Jackson County.

*	N 43 1/2° W	Double (12" & 16") Hickory	2.9'	40d & washer on East side 16"
**	N 15° W	Triple Maple(9"-6"-11")	30.23'	40d & washer on East side 9"
***	N 55° E	18" Hickory	48.53'	40d & washer on Southeast side
****	East	19" Maple	31.76'	40d & washer on South side
	N 70° W	8" Hickory(center of 3)	36.75'	40d & washer on South side
	N 20 E	18" Oak	24.80'	Found 30d on East side
	S 40 E	18" Ash	20.10'	Found 30d on Southwest side
	S 75 W	10" Ash	24.85'	Found 30d on North side
	North	Steel post and survey marker sign attached	3.0'	

Signed by _____

November 30, 1996

Surveyor's Michigan License No. _____

18658

Continued,

I-12

T4S, R2E

- A.) - Perpetuation by F. G. Riley, #377, 1923. Found fireclay
 * Double Hickory 11" N 43½ W 2.58'
 in line of North & South fence and 1.75' South of East & West fence
- Perpetuation by Richard E. Gutekunst, RLS #7863, dated 4/12/68.
- Found fireclay
- | | | | |
|------|------|----------------|--------|
| * | NWly | Double Hickory | 2.9' |
| ** | NWly | Triple Maple | 30.22' |
| *** | NEly | 18" Hickory | 48.53' |
| **** | East | 15" Maple | 31.75' |
- Not recorded in P.A. 74.