

JACKSON COUNTY  
 APPROVED LAND CORNER  
 P.A. 345 of 1970  
 ACTING  
 Chairman [Signature]  
 Date 12-11-96

SOUTH 1/4 POST, SECTION 26  
 NORVELL TOWNSHIP

LAND CORNER RECORDATION CERTIFICATE  
 Filing Requirement of Act 74, Mich. P.A. 1970

For corners in  
JACKSON  
 (County)

	Located In:	Corner Code #
1. Public Land Survey	T <u>4</u> S R <u>2</u> E	<u>J-11</u>
	T _____ R _____	_____
	T _____ R _____	_____
	T _____ R _____	_____
2. Property Controlling in Section	S _____ T _____ R _____	_____
	S _____ T _____ R _____	_____
3. Miscellaneous Property in Sec.	S _____ T _____ R _____	_____
	S _____ T _____ R _____	_____
4. Lot No. _____, Recorded Plat _____		
5. Private Claims _____		

#2022470  
 Liber 1533 Page 350  
 Page 1 of 2  
 Jackson Co., MI  
 Recorded  
 12/12/96 01:04P  
 Jerry McDevitt  
 Register of Deeds

Register of Deeds Stamp & File Number

I, DEAN R. GUTEKUNST, in a field survey on November 14, 1996, do hereby certify that under requirements of P.A. 74, Michigan P.A. of 1970, the corner points mentioned in lines 1 and 2 above were in conformance with regulations and rules therefore as required in the current manual of survey instructions of the United States Department of the Interior, Bureau of Land Management or by a decree of a Court of Law and/or that the corner points mentioned in lines 3, 4 and 5 above were in conformance with the rules of the Michigan Board of Land Surveyors or by a Decree of a Court of Law; established, re-established, monumented, re-monumented, recovered, found as expressed below:

	A	B	C	D	E	F	G	H	I	J	K	L	M
2	6	5	4	3	2	1							
3													
4	7	8	9	10	11	12							
5													
6	18	17	16	15	14	13							
7													
8	19	20	21	22	23	24							
9													
10	30	29	28	27	26	25							
11										⊕			
12	31	32	33	34	35	36							
13													

NOTE: Not more than 4 corners, all in the same town and range, may be recorded on this certificate.

A. Description of original monument and accessories and/or subsequent restoration:

Original Government Post set by Hervey Parke, Deputy Surveyor, February 1824.  
 Tamarack 5" East 60 links (39.60')  
 Tamarack 5" N 18 W 6 links (3.96')  
 Perpetuation by B. F. LaRue, November 26, 1884  
 Tamarack 5" N 7 3/4 E 76 links (50.16')  
 Tamarack 4" N 68 E 25 links (16.5')  
 Oak 1/2" N 70 3/4 E 65 1/4 links (43.065')

In large marsh, found a piece of broken stone and slight trace of stake at just the place where Mr Main said it was supposed to be according to Mr Curtis.

Continued on back,


B. Description of corner evidence found and/or method applied in restoring or reestablishing corner:

Found 18" of FIRECLAY, broken in 4 pieces, no top or bottom. Iron pipe was gone.  
 Corner is 3' 1/2 East of a North & South 6' wide ditch, and in line with fence West.  
 Accepted lowest piece of FIRECLAY as a careful and faithful perpetuation of the position of the original corner, as remonumented by LaRue in 1884.  
 Set a 1" X 60" aluminum pipe with cap to replace the fireclay and left pieces of the fireclay buried around pipe.

C. Description of monument for corner and accessories established to perpetuate locating the position of the corner:

J-11 T4S, R2E Corner is a 1" X 60" aluminum pipe with an aluminum cap stamped LS 18658, which is a standard monument for Jackson County, in low marshy areas.

N 10° E	Double (8" & 9") Maple	153.95'	40d & washer on East side
N 75° E	7" Poplar	42.35'	Found 40d on South side
East	3" Elm	17.9'	center line, no nail
S 45° E	6" Elm	39.39'	Found 40d on North side
S 10° E	Double (4" & 5") Elm	89.31'	40d & washer on West side
West	Steel post and survey marker sign attached	1.0'	

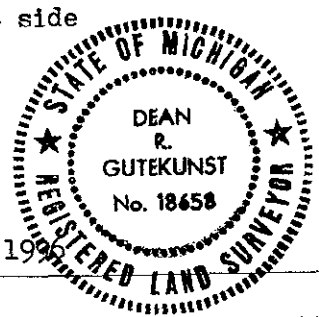

Signed by [Signature] Date November 30, 1996  
 Surveyor's Michigan License No. 18658

Continued,

J-11 T4S, R2E

- A.) - Perpetuation by Richard E. Gutekunst, RLS # 7863, on September 16, 1972 and recorded in LCRC, Liber 1, Page 619, Jackson County Records, under P.A.-74

Found broken fireclay

Set 3/4" X 5' capped iron on West side of fireclay.

West Double 4" Elm 44.34'

Corner is on East side of a 6' ditch and approximately in line of fences North and West.

- P.A.- 74, recorded by Werner Sommer, # 12030, dated October 17, 1974 in LCRC, Liber 2, Page 443, Jackson County Records.

Found iron pipe West of fireclay

East side of 6' ditch at fence.