

**JACKSON COUNTY
APPROVED LAND CORNER
P.A. 343 of 1990**

Chairman Dean K. Hubbard
Date Sept 9, 1998

North 1/4 Corner of Section 36, Norvell Township

LAND CORNER RECORDATION CERTIFICATE

Filing Requirement of Act 74, Mich. P.A. 1970

**SURVEY &
REMONUMENTATION**

JAN 27 1999

For corners in
JACKSON
(County)

Located in:

Corner Code #

SECTION

1. Public Land Survey

T4S R2E
T ___ R ___
T ___ R ___
T ___ R ___

L-11



2087043
Page: 1 of 1
09/10/1998 11:
L-1580 P-5

2. Property Controlling
in Section

S ___ T ___ R ___
S ___ T ___ R ___

3. Miscellaneous
Property in Sec.

S ___ T ___ R ___
S ___ T ___ R ___

4. Lot No. _____, Recorded Plat _____

5. Private Claims _____

Register of Deeds Stamp & File Number

	A	B	C	D	E	F	G	H	I	J	K	L
1												
2		6		5		4		3		2		1
3												
4		7		8		9		10		11		12
5												
6		18		17		16		15		14		13
7												
8		19		20		21		22		23		24
9												
10		30		29		28		27		26		25
11												
12		31		32		33		34		35		36
13												

I, David E. Erickson, in a field survey on November 11, 19 97, do hereby certify that under requirements of P.A. 74, Michigan P.A. of 1970, the corner points mentioned in lines 1 and 2 above were in conformance with regulations and rules therefore as required in the current manual of survey instructions of the United States Department of the Interior, Bureau of Land Management or by a decree of a Court of Law and/or that the corner points mentioned in lines 3, 4 and 5 above were in conformance with the rules of the Michigan Board of Land Surveyors or by a Decree of a Court of Law; established, re-established, monumented, re-monumented, recovered, found as expressed below:

NOTE: Not more than 4 corners, all in the same town and range, may be recorded on this certificate.

A. Description of original monument and accessories and/or subsequent restoration:

In 1824, H. Parke "set post" and listed two witnesses: "W. Oak 40, N53°E, 39" (25.74') and "do 10, S32°W, 46" (30.36').

In 1977, K.L. Suydam - LS #17636, recorded the corner as "Found fireclay (FC) post in old East & West fence line" and lists three witnesses: "Nail & Washer in 30" W. Oak S15°W, 82.75"; "Nail & Washer in 20" W. Oak S58°W, 21.01"; "Nail & Washer in 18" Red Oak N57°E, 21.14' ".

B. Description of corner evidence found and/or method applied in restoring or reestablishing corner:


Found top 1.25' of Fire Clay (FC) in old fallen down East-West fence line. An Iron Pipe (IP) with cap #7863 and a 1/2" rebar are on the North side. Found bottom section of FC 0.18' Southwesterly of top portion. Bottom is down 1.3' with lime below it. Accepted found lower section of FC as a careful and faithful perpetuation of the original corner. Replaced FC with a standard concrete monument. Buried irons on North side and piece of FC on South side of monument. Corner is 40'+ Northwest of a wood shed for #12111 Beech Drive.

C. Description of monument for corner and accessories established to perpetuate locating the position of the corner:

Set 4" x 36" concrete monument with cap stamped "T4S-R2E, L-11, 1997, LS #29245".

N 61° E	Set nail and tag #29245, South side 18" Oak	22.22'
S 07° W	Set nail and tag #29245, West side triple 18" Oak	36.15'
S 16° W	Set nail and tag #29245, West side 39" Oak	62.64'
N 50° W	Set nail and tag #29245, South side 15" Oak	35.99'
North	County Surveyor sign post	1.0'

NOTE: Bearings are magnetic

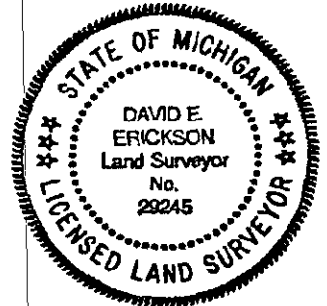

Signed by David Erickson Date 9-8-98

Surveyor's Michigan License No. 29245

FORM APPROVED BY MICHIGAN STATE BOARD OF LAND SURVEYORS, JAN. 28, 1971

REVISED MAY 14, 1975
REVISED JAN. 1983
ADAPTED FOR WORD PROCESSING MARCH, 1985