

Plat 399 of 1999
 Chairman *Dean [Signature]*
 Date Feb. 10, 1999

West 1/4 Corner of Section 18, Hanover Township
LAND CORNER RECORDATION CERTIFICATE
 Filing Requirement of Act 74, Mich. P.A. 1970

SURVEY & REMONUMENTATION
 MAR 13 2000
SECTION

For corners in JACKSON Located in: _____ Corner Code # _____
 (County)

1. Public Land Survey T 4S R 2W _____
 T _____ R _____
 T _____ R _____
 T _____ R _____
 2. Property Controlling S _____ T _____ R _____
 in Section S _____ T _____ R _____
 3. Miscellaneous S _____ T _____ R _____
 Property in Sec. S _____ T _____ R _____
 4. Lot No. _____, Recorded Plat _____
 5. Private Claims _____

2104472
 Page: 1 of 1
 02/10/1999 10:51A
 L-1593 P-288
 MIndy Reilly - Jackson Co. CORREM

Register of Deeds Stamp & File Number

	A	B	C	D	E	F	G	H	I	J	K	L	M
1													
2	6	5	4	3	2	1							
3													
4	7	8	9	10	11	12							
5													
6	18	17	16	15	14	13							
7													
8	19	20	21	22	23	24							
9													
10	30	29	28	27	26	25							
11													
12	31	32	33	34	35	36							
13													

I, David E. Erickson, in a field survey on April 27, 1998, do hereby certify that under requirements of P.A. 74, Michigan P.A. of 1970, the corner points mentioned in lines 1 and 2 above were in conformance with regulations and rules therefor as required in the current manual of survey instructions of the United States Department of the Interior, Bureau of Land Management or by a decree of a Court of Law and/or that the corner points mentioned in lines 3, 4 and 5 above were in conformance with the rules of the Michigan Board of Land Surveyors or by a Decree of a Court of Law, established, re-established, monumented, re-monumented, recovered, found as expressed below:

NOTE: Not more than 4 corners, all in the same town and range, may be recorded on this certificate.

A. Description of original monument and accessories and/or subsequent restoration:

This corner not established in the original government survey.

Corner not recorded under P.A. #74.


B. Description of corner evidence found and/or method applied in restoring or reestablishing corner:

Found a RR spike leaning NE'ly, likely disturbed in loose soil, 0.94' North of single proportionate location. Excavated with backhoe, a 4' E-W x 8' N-S hole, 2' deep into native soil, centered on RR spike. Nothing further found. Also excavated a hole of similar size, opposite a fence line East. Nothing found at this location, likely established 2640' South of the NW corner. Re-established corner midway between A-5 and A-7, as remonumented, and on Township line. Set a standard Jackson County Harrison Cast Iron Monument on the Township line.

C. Description of monument for corner and accessories established to perpetuate locating the position of the corner:

Set standard Jackson County Harrison Cast Iron Monument, stamped "A-6, #29245".

N19°E	Set Nail & Tag #29245 in Northeast side 30" Oak	85.24'
S82°E	Set Nail & Tag #29245 in North side 28" Oak	144.27'
S9°W	Set Nail & Tag #29245 in East side 26" Oak	269.97'
N57°W	Set Nail & Tag #29245 in North side Power Pole	209.06'
East	County Surveyor sign post	10.0'
West	Centerline gravel road	9.0'
South	Fence line East	18'
North	Corner M-6, T4S-R3W, Harrison monument	118.91'
North	Corner A-5, Harrison monument	2623.15'
South	Corner A-7, Jackson county concrete monument (Liber 1482, Page 647)	2623.15'

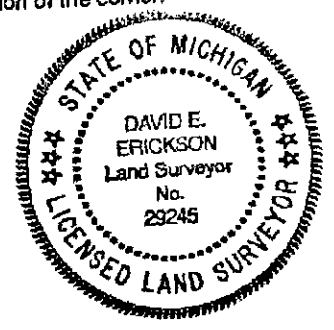

Note: Bearings are magnetic.

Signed by David Erickson Date 2-9-99

Surveyor's Michigan License No. 29245