

MAR 13 2000

SECTION

Northeast Corner of Section 7, Hanover Township

LAND CORNER RECORDATION CERTIFICATE

Filing Requirement of Act 74, Mich. P.A. 1970

County JACKSON
 Date Feb. 10, 1999

For corners in JACKSON (County) Located In: Corner Code #

1. Public Land Survey T 4S R 2W C-3
 T _____ R _____
 T _____ R _____
 T _____ R _____

2. Property Controlling in Section S _____ T _____ R _____
 S _____ T _____ R _____

3. Miscellaneous Property in Sec. S _____ T _____ R _____
 S _____ T _____ R _____

4. Lot No. _____ Recorded Plat _____

5. Private Claims _____



2104475
 Page: 1 of 1
 02/10/1999 10:51A
 L-1593 P-268

Register of Deeds Stamp & File Number

1	A	B	C	D	E	F	G	H	I	J	K	L	M
2	6	5	4	3	2	1							
3													
4	7	8	9	10	11	12							
5													
6	18	17	16	15	14	13							
7													
8	19	20	21	22	23	24							
9													
10	30	29	28	27	26	25							
11													
12	31	32	33	34	35	36							
13													

I, David E. Erickson, in a field survey on May 11, 19 98, do hereby certify that under requirements of P.A. 74, Michigan P.A. of 1970, the corner points mentioned in lines 1 and 2 above were in conformance with regulations and rules therefore as required in the current manual of survey instructions of the United States Department of the Interior, Bureau of Land Management or by a decree of a Court of Law and/or that the corner points mentioned in lines 3, 4 and 5 above were in conformance with the rules of the Michigan Board of Land Surveyors or by a Decree of a Court of Law; established, re-established, monumented, re-monumented, recovered, found as expressed below:

NOTE: Not more than 4 corners, all in the same town and range, may be recorded on this certificate.

A. Description of original monument and accessories and/or subsequent restoration:

In 1825, Robert Clark, Jr. - Deputy Surveyor, set a "Post" and recorded two witnesses: "W. Oak 12, N25 1/2°E, 99" (65.34') and "W. Oak 8, S81 1/2°E, 40 1/2" (26.73').

In 1886, H.F. Bean reported "Post out, found remains of Witnesses." and notes two witnesses: "W. Oak 30 N4°W 22 1/2" (146.19') and "Hickory, 14" East, 48 1/2" (304.59').

This corner not recorded under Act #74.

B. Description of corner evidence found and/or method applied in restoring or reestablishing corner:


Excavated area with backhoe. Found intact Fire Clay (FC), down 1.5', surrounded by stones. Fits stone rows North, South, and West. Left FC intact, but broke top off during excavation. Placed 3 1/2" x 24" rebars around FC. Accepted Fire Clay as a careful and faithful perpetuation of the original corner. Set a standard 60" long, Jackson County Aluminum Pipe Monument, leaning slightly to the West so cap is over the center of the FC. The FC is on the West side of monument. Placed stones around the monument, which is up 0.2'.

C. Description of monument for corner and accessories established to perpetuate locating the position of the corner:

Set a standard 60" long Jackson County Aluminum Pipe Monument, with cap stamped "C- 3, T4S-R2W, 1998, LS#29245".

S3°W	Set Nail & Tag #29245 in West side 20" Cherry	143.18'
S8°W	Set Nail & Tag #29245 in West side 8" Cherry	95.83'
S85°W	Set Nail & Tag #29245 in West side 12" Cherry	250.39'
S85°W	Set Nail & Tag #29245 in South side 6" Cherry	151.62'
West	County Surveyor sign post	1.0'

Note: Bearings are magnetic.

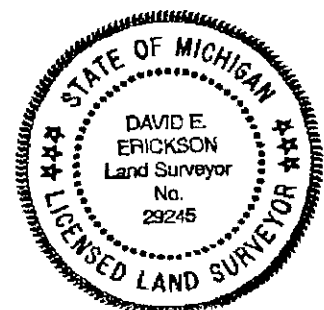

Signed by David Erickson Date 2-9-99

Surveyor's Michigan License No. 29245