

**JACKSON COUNTY  
APPROVED LAND CORNER  
P.A. 345 of 1990**

NORTHWEST CORNER, SECTION 29  
HANOVER TOWNSHIP

ACTING Chairman *David Erickson*  
Date 6-11-97

**LAND CORNER RECORDATION CERTIFICATE  
Filing Requirement of Act 74, Mich. P.A. 1970**

#2037502  
Liber 1544 Page 371  
Page 1 of 2  
Jackson Co., MI  
Recorded  
06/11/97 11:31A  
Mindy Reilly  
Register of Deeds

For corners in  
JACKSON  
(County)

Located In: Corner Code #

- |                                    |   |     |   |     |     |
|------------------------------------|---|-----|---|-----|-----|
| 1. Public Land Survey              | T | 4 S | R | 2 W | C-9 |
|                                    | T |     | R |     |     |
|                                    | T |     | R |     |     |
|                                    | T |     | R |     |     |
|                                    | T |     | R |     |     |
| 2. Property Controlling in Section | S |     | T |     | R   |
| 3. Miscellaneous Property in Sec.  | S |     | T |     | R   |
- SURVEY & REMONUMENTATION**
- SEP 8 2 1997

Register of Deeds Stamp & File Number

4. Lot No. \_\_\_\_\_, Recorded Plat \_\_\_\_\_ SECTION \_\_\_\_\_  
5. Private Claims \_\_\_\_\_

I, DEAN R. GUTEKUNST, in a field survey on May 7, 1997 & May 19, 1997, do hereby certify that under requirements of P.A. 74, Michigan P.A. of 1970, the corner points mentioned in lines 1 and 2 above were in conformance with regulations and rules therefore as required in the current manual of survey instructions of the United States Department of the Interior, Bureau of Land Management or by a decree of a Court of Law and/or that the corner points mentioned in lines 3, 4 and 5 above were in conformance with the rules of the Michigan Board of Land Surveyors or by a Decree of a Court of Law; established, re-established, monumented, re-monumented, recovered, found as expressed below:

**NOTE: Not more than 4 corners, all in the same town and range, may be recorded on this certificate.**

**A. Description of original monument and accessories and/or subsequent restoration:**

- Original Government Post set by Robert Clark, Deputy Surveyor, 1825.  
Hickory 8" S 12 E 13 links (8.58')  
Hickory 6" S 78 W 9 links (5.94')  
Perpetuation by H. F. Bean, July 1886  
Y. Oak 22" N 58 E 78½ links (51.81')  
\* W. Oak 12" N 9 W 61 links (40.26')

Stone corner standing, set fireclay post 1½ rods North.



Continued on back,

**B. Description of corner evidence found and/or method applied in restoring or reestablishing corner:**

Found Stone, about 18" below surface of Hanover Road (blacktop) under iron in box. Stone is 5" X 12" on top and 6" X 6" at bottom and 2.5' long.  
Corner is on center line of Hanover Road and 3¼ East of center line of Strait Road (gravel) running South.  
Did not find Fireclay 24.75' North, but did find 6 to 8 pieces of broken brick surrounded by stone. CAUTION - a bell telephone wire is buried 12" below, surface of the lawn, over the position 24.75' North of the corner.  
Accepted the Stone as a careful and faithful perpetuation of the position of the original corner as remonumented by H. F. Bean in 1886.  
Set a Standard Jackson County Monument to replace the Stone and reset the Stone 4' below the surface, with the old bent ½" X 18" pinched iron on the North side of the Stone.

**C. Description of monument for corner and accessories established to perpetuate locating the position of the corner:**

- C-9 T4S, R2W Corner is 4" diameter X 30" Cast Iron Harrison monument with a Brass cap stamped 18658, which is the standard monument for Jackson County.
- \* N 90° W 46" Oak 40.39' Pole barn spike and washer on East side.
  - \*\* N 22° W Southeast corner foundation house #9014 115.05 (stone foundation)
  - \*\*\* N 63° W 31" Hickory 98.09' Pole barn spike and washer on Northeast side.
  - \*\*\*\* S 73° W 30" Hickory 105.88' Pole barn spike and washer on North side.
  - S 23° W 20" Hickory 90.82' Pole barn spike and washer on East side.
  - S 14° E 28" Hickory 120.80' Pole barn spike and washer on East side.
  - S 75° E 7" Hickory 130.27' Pole barn spike and washer on North side.
  - N 65° E 11" Oak 64.22' Pole barn spike and washer on North side.

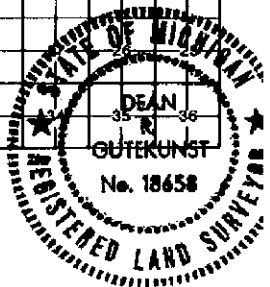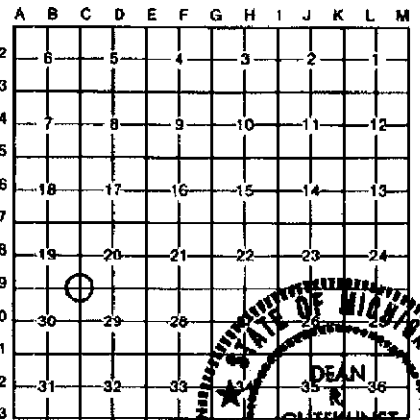

Signed by Dean R. Gutekunst Date June 1, 1997  
Surveyor's Michigan License No. 18658

C-9 T4S, R2W

Continued,

- A.) - Perpetuation by Richard E. Gutekunst, RLS # 7863, dated March 20, 1968.  
 Found iron and 1 witness standing and stump of another. Did not find  
 Fireclay  $1\frac{1}{2}$  rods North
- |      |       |                                   |         |         |
|------|-------|-----------------------------------|---------|---------|
| *    | N 9 W | 40" Oak                           | 40.64'  |         |
| **   | NW    | Southeast corner of house # 9014' |         | 115.13' |
| ***  | NW    | 25" hickory                       | 97.76'  |         |
| **** | SW    | 20" Hickory                       | 105.98' |         |
|      | SW    | 16" Hickory                       | 116.15' |         |
|      | SE    | 24" Oak                           | 52.32'  |         |
|      | NE    | 32" Oak                           | 111.38' |         |
- Not recorded in PA - 74.

SURVEY &  
 REMONUMENTATION

SEP 9 2 1995

SECTION