

JACKSON COUNTY
APPROVED LAND CORNER
P.A. 345 of 1998
 ACTING
 Chairman *[Signature]*
 Timothy C. Thompson
 Date 08-13-97

WEST 1/4 POST, SECTION 32
 HANOVER TOWNSHIP

LAND CORNER RECORDATION CERTIFICATE
 Filing Requirement of Act 74, Mich. P.A. 1970


For corners in
JACKSON
 (County)

Located In:	Corner Code #
T 4 S R 2 W	C-12
T _____ R _____	REMONUMENTATION
T _____ R _____	APR 07 1998
T _____ R _____	SECTION
T _____ R _____	Register of Deeds Stamp & File Number
S _____ T _____ R _____	
S _____ T _____ R _____	
S _____ T _____ R _____	
S _____ T _____ R _____	

#2044406
 Liber 1549 Page 126
 Page 1 of 1
 Jackson Co., MI
 Recorded
 08/15/97 10:47A
 Mindy Reilly
 Register of Deeds

Lot No. _____, Recorded Plat _____
 Private Claims _____

DEAN R. GUTEKUNST, in a field survey on May 7, 97 & June 11, 1997,
 hereby certify that under requirements of P.A. 74, Michigan P.A. of 1970, the corner points mentioned
 in lines 1 and 2 above were in conformance with regulations and rules theretofore as required in the
 current manual of survey instructions of the United States Department of the Interior, Bureau of Land
 Management or by a decree of a Court of Law and/or that the corner points mentioned in lines 3, 4 and 5
 above were in conformance with the rules of the Michigan Board of Land Surveyors or by a Decree of a
 Court of Law; established, re-established, monumented, re-monumented, recovered, found as
 expressed below:

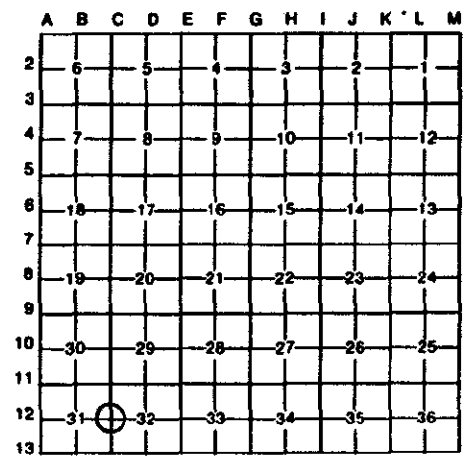

NOTE: Not more than 4 corners, all in the same town and range, may be recorded on this certificate.

Description of original monument and accessories and/or subsequent restoration:

- Original Government Post set by Robert Clark, Deputy Surveyor, 1825
 - B. Oak 10" N 24 W 202 links (133.32')
 - B. Oak 10" N 28 1/2 E 214 links (141.24')
- Perpetuation by H. F. Bean, July 1886
 - Cherry 12" N 8 1/2 W 310 links (204.60')
 - Tamarack 2" S 84 1/2 E 56 lines (36.96')

Limestone 10' West of corner.
 Found remains of witness.
 Post kept up.

Not recorded in P. A. - 74.

Description of corner evidence found and/or method applied in restoring or reestablishing corner:

Found bottom 6" of Fireclay, standing with broken brick under. Also found two mid pieces of fireclay, top gone.
 Backhoe excavation by Jackson County Road Commission, found fireclay approximately 2' below surface, but did not find limestone 10' West.
 Surface iron found was approximately 0.6' West.
 Corner is 4'± North of row of Cedar's, running East and 3'± West of center line of Strait Road (gravel).
 Accepted Fireclay as a careful and faithful perpetuation of the position of the original corner as remonumented by Bean in 1886.

Set a Standard Jackson County Monument to replace the fireclay and left broken brick pieces buried under monument and two pieces of fireclay buried on North and South side of monument.

Description of monument for corner and accessories established to perpetuate locating the position of the corner:

- C-12 T4S, R2W Corner is a 4" diameter X 30" Cast Iron Harrison monument with a brass cap stamped LS 18658, which is a standard monument for Jackson County.
 - S 85° E 12" Cedar 85.84' Pole barn spike and washer on North side.
 - S 25° E 44" Maple 124.80' Pole barn spike and washer on Southwest side.
 - S 30° W 24" Oak 49.75' Pole barn spike and washer on Northwest side.
 - N 10° W 33" Oak 128.05' Pole barn spike and washer on East side.
 - N 24° E 18" Oak 87.90' Pole barn spike and washer on East side.
 - N 74° W Utility Pole 26.60' Pole barn spike and washer on South side.
 - West Steel post and survey marker sign attached 25'

Recorded by Dean R. Gutekunst Date August 1, 1997
 Surveyor's Michigan License No. 18658

FORM APPROVED BY MICHIGAN STATE BOARD OF LAND SURVEYORS, JAN. 20, 1988

